



EQUIPMENT NO.	SERVICE	NOTE
40FB-09	NExBTL PRODUCT TANK	CATEGORY 3
40FB-10	NExBTL PRODUCT TANK	CATEGORY 3
40FB-11	NExBTL PRODUCT TANK	CATEGORY 3
40FB-12	NExBTL PRODUCT TANK	CATEGORY 3
40FB-15	BIO-NAPHTHA TANK	CATEGORY 1
40GA-04A	NExBTL PRODUCT LOADING PUMP	
40GA-04B	NExBTL PRODUCT LOADING PUMP	
40GA-06	NAPHTHA LOADING PUMP	
40GA-06S	NAPHTHA LOADING PUMP	
40GA-07	VRU ABSORBENT SUPPLY PUMP	
45PK-01	VAPOUR RECOVERY UNIT	
60AD-47	BIONAPHTHA TANK OILY WATER SUMP	
60GA-47A	BIONAPHTHA TANK OILY WATER SUMP PUMP	
60GA-47B	BIONAPHTHA TANK OILY WATER SUMP PUMP	
60AD-50	NExBTL PRODUCT TANKS OILY WATER SUMP	
60GA-50A	NExBTL PRODUCT TANKS OILY WATER SUMP PUMP	
60GA-50B	NExBTL PRODUCT TANKS OILY WATER SUMP PUMP	
60AD-52	JETTY B.L. STORM WATER SUMP	
60GA-63A	JETTY B.L. STORM WATER PUMP	
60GA-63B	JETTY B.L. STORM WATER PUMP	
60AD-74	HARBOUR CONTROL ROOM SANITARY SUMP	
60GA-74	HARBOUR CONTROL ROOM SANITARY SUMP PUMP	
60GA-74S	HARBOUR CONTROL ROOM SANITARY SUMP PUMP	
85PK-01	FDAM BLADDER TANKS PACKAGE	

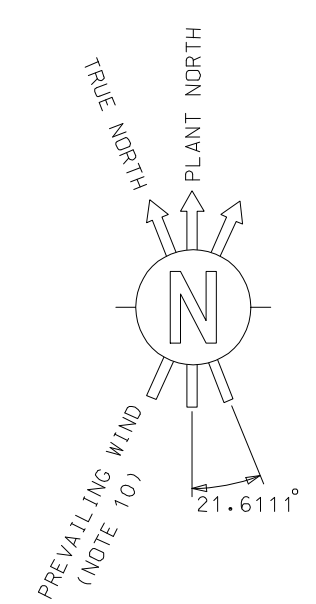

- GENERAL NOTES
- COORDINATES ARE REFERRED TO PLANT NORTH. THE ORIGIN OF THE SYSTEM IS THE OUTER NORTH-WEST CORNER OF THE PLANT (N=443093 / E=62008) CORRESPONDING TO N=1000.000 / E=1000.000
 - ALL DIMENSIONS AND ELEVATIONS ARE IN MILLIMETERS AND 360° DEGREES CIRCLE UNLESS OTHERWISE INDICATED
 - ALL COORDINATES ARE IN METERS
 - THE ELEVATION 100.000 CORRESPONDS TO (HIGHT POINT OF PAVING) AND IS EQUIVALENT +5.20 m. N.L.A.P.
 - T.L. TANGENT LINE EQUIPMENT
T.O.C. TOP OF CONCRETE
C. CENTER LINE
T.O.S. TOP OF STEEL
H.P.P. HIGHEST PAVING POINT
E.L. ELEVATION
F.S. FIXED SADDLE
 - — — — — DENOTES BOUNDARY LIMIT
 - X — X — DENOTES FENCE LIMIT
 - — — — — DENOTES ZONE LIMIT
 - — — — — DENOTES AREA LIMIT
 - PREVAILING WIND DIRECTION SOUTH WEST
 - DENOTES ROAD CROSSING
 - TANK FARM LAY-OUT ARE IN ACCORDING WITH DUTCH REGULATION PGS-29
 - DENOTES LIGHTING TOWER

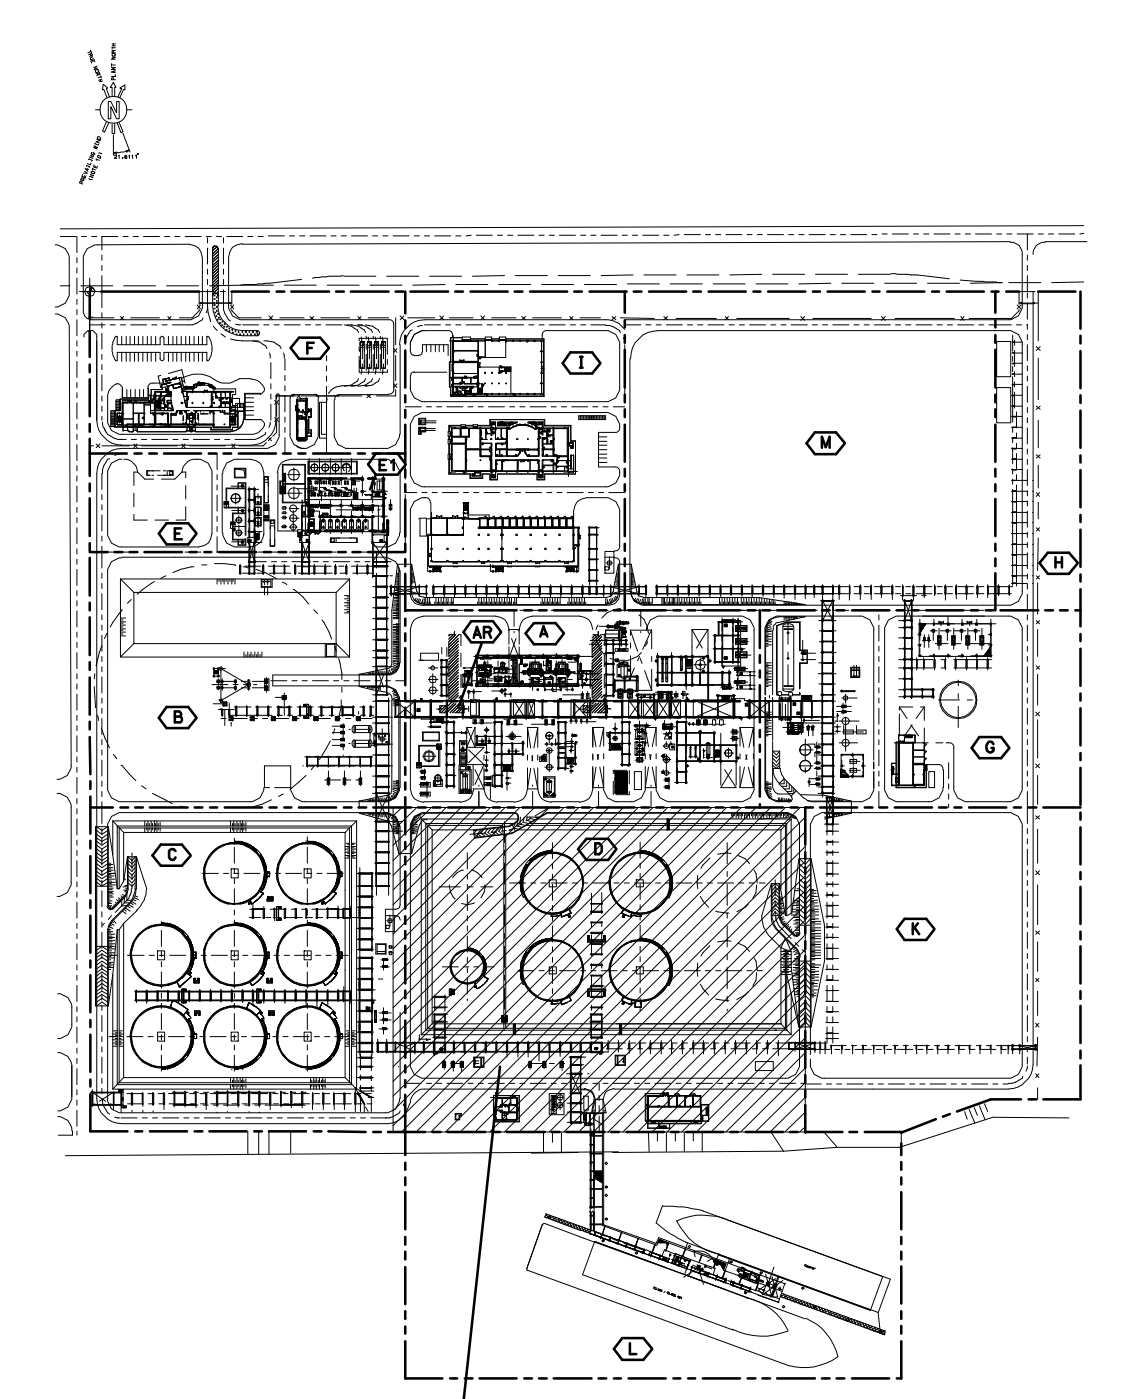

KEY PLAN

REF.	DESCRIPTION
2305-000-04-1331-01	DETAILED KEY PLAN ZONE "D"
2305-000-04-1331-01	OVERALL KEY PLAN
2305-000-04-0051-02	OVERALL PLOT PLAN
Drawing No.	DESCRIPTION
REFERENCE DRAWINGS	

REV	DATE	DESCRIPTION	PREP	CHK	APPR	AUTH
04	15-SEP-2011	AS BUILT	A.LONIGARDOZZI	F.RAMP1	F.BARONE	J.D.LOPEZ










NESTÉ OIL
TECHNIP ITALY S.p.A.

ROTTERDAM - NExBTL PLANT

ZONE "D"
DETAILED PLOT PLAN AND ELEVATIONS

SCALE	2305	000	DW	00	51	01	1 of 1	0A
Project	Unit	Doc.Type	Disc	Subj	Ser.No	Page	Rev.	
NESTÉ-OIL Drawing No								
Cad Model								

TECHNIP ITALY S.p.A. - 00148 ROMA - Viale Castello della Magliana, 68

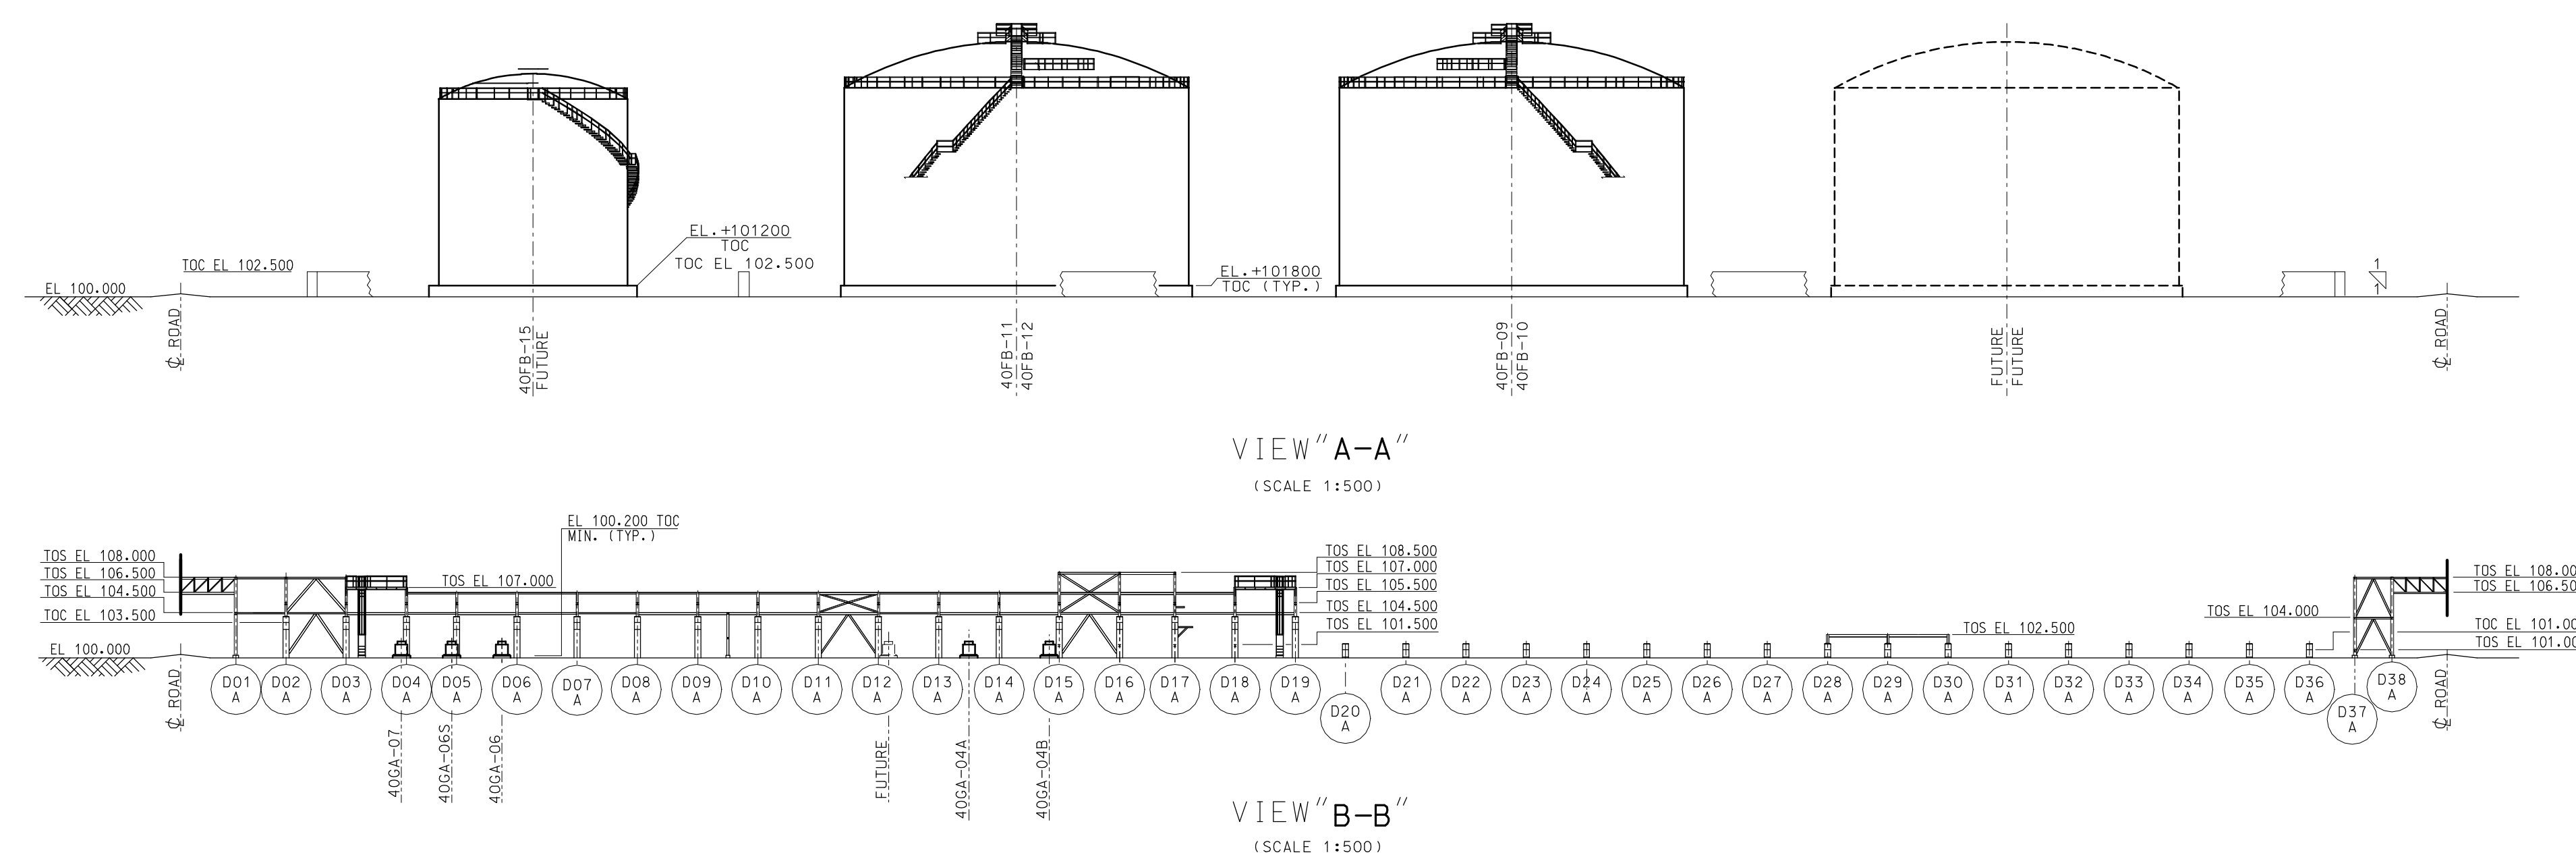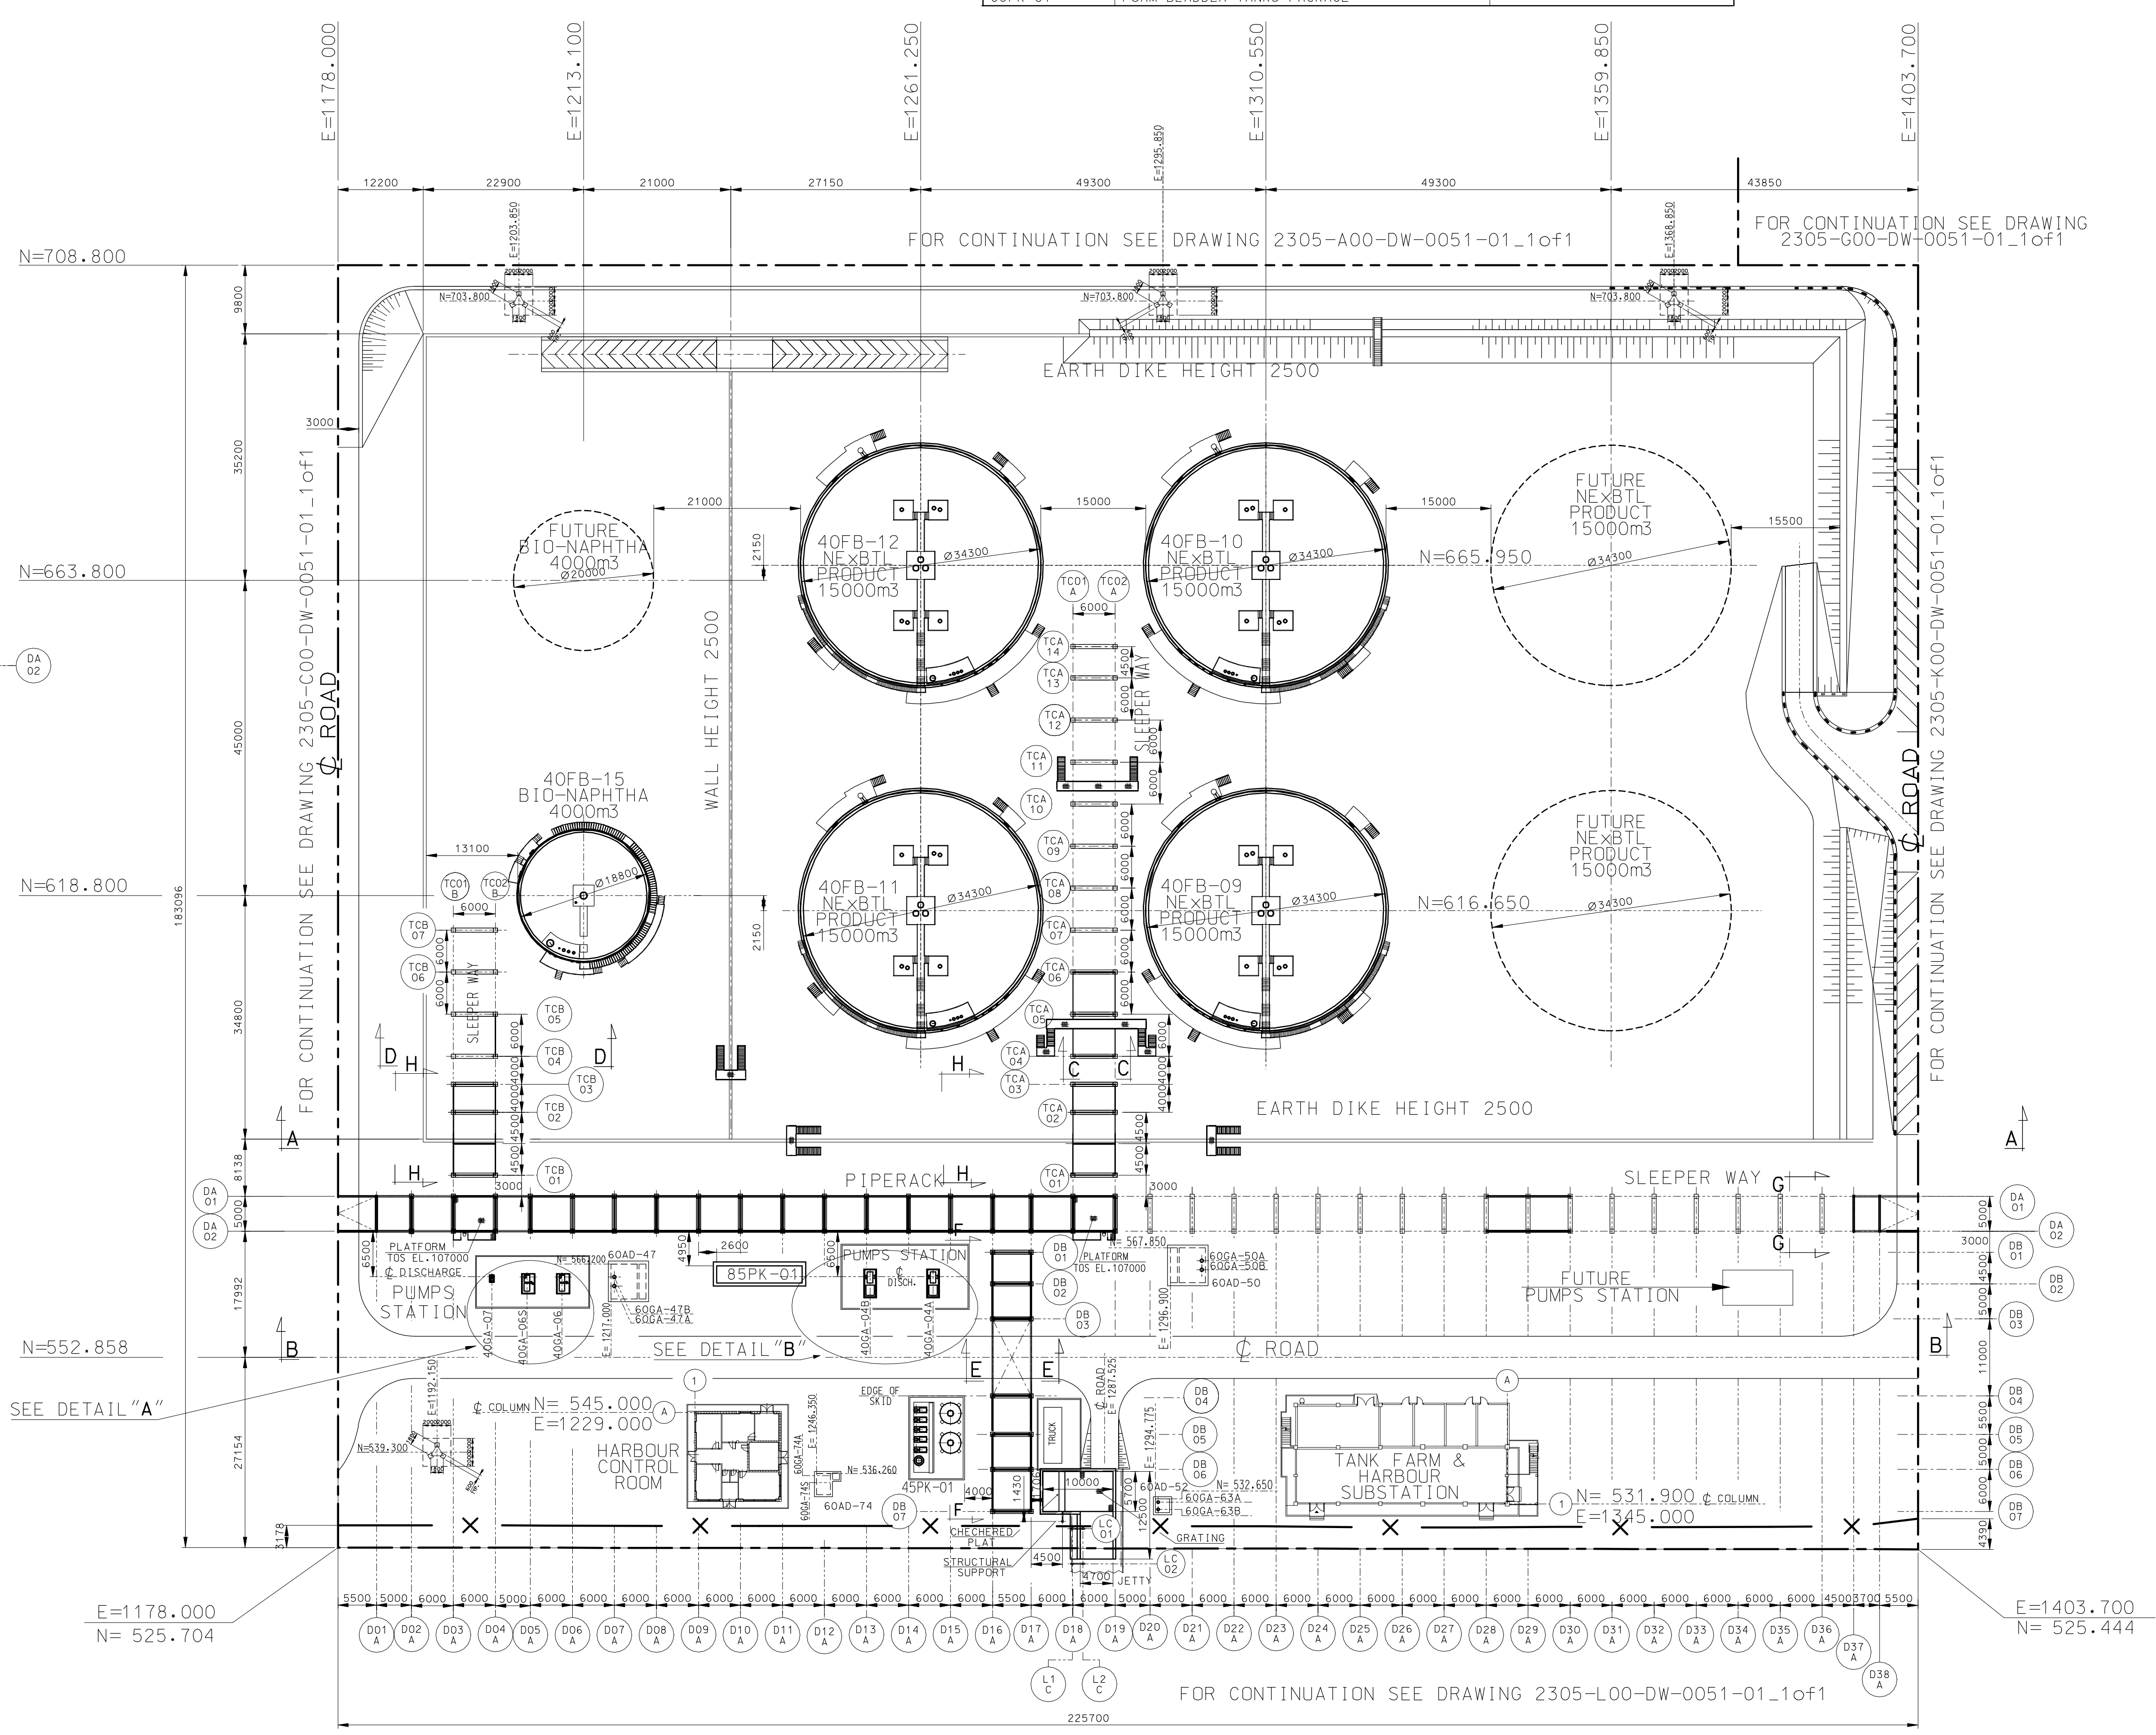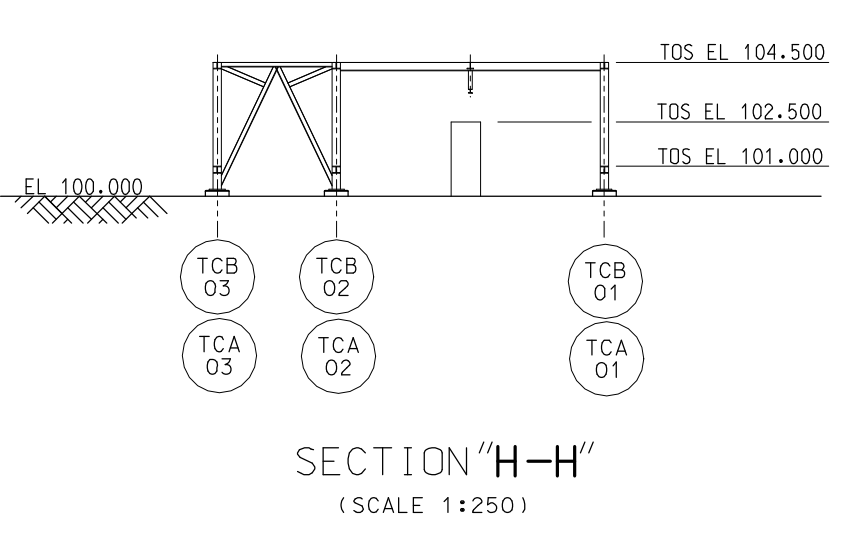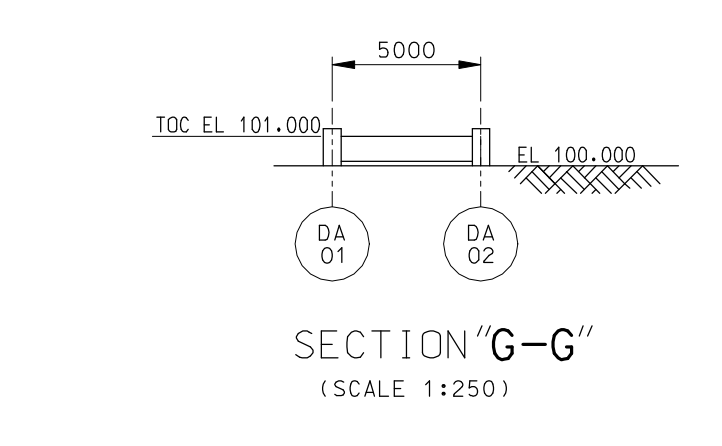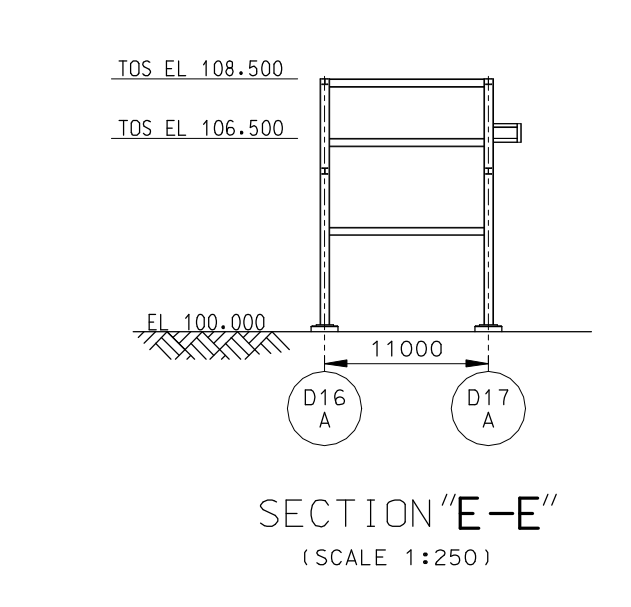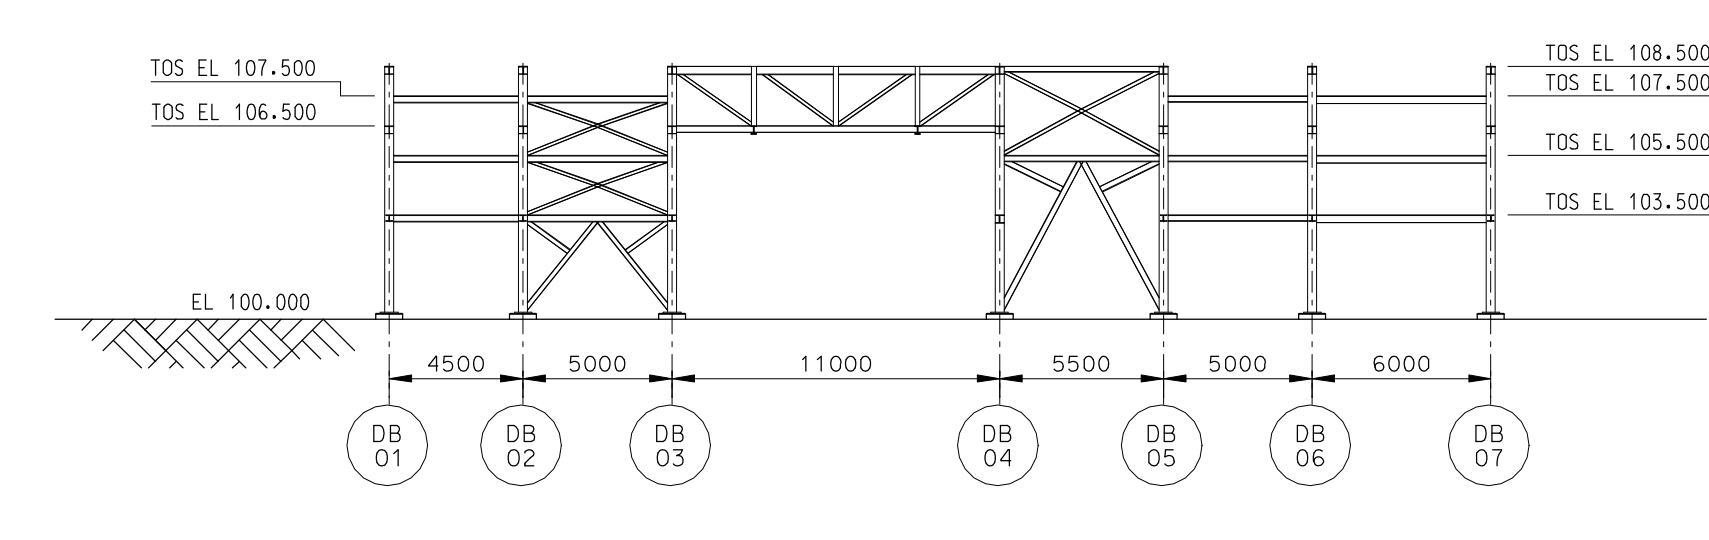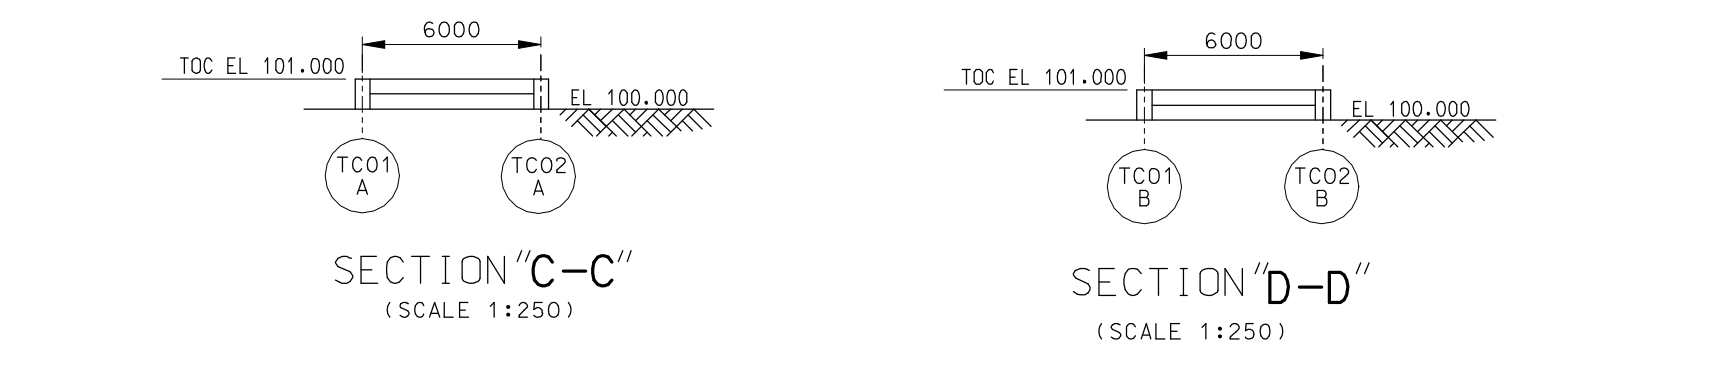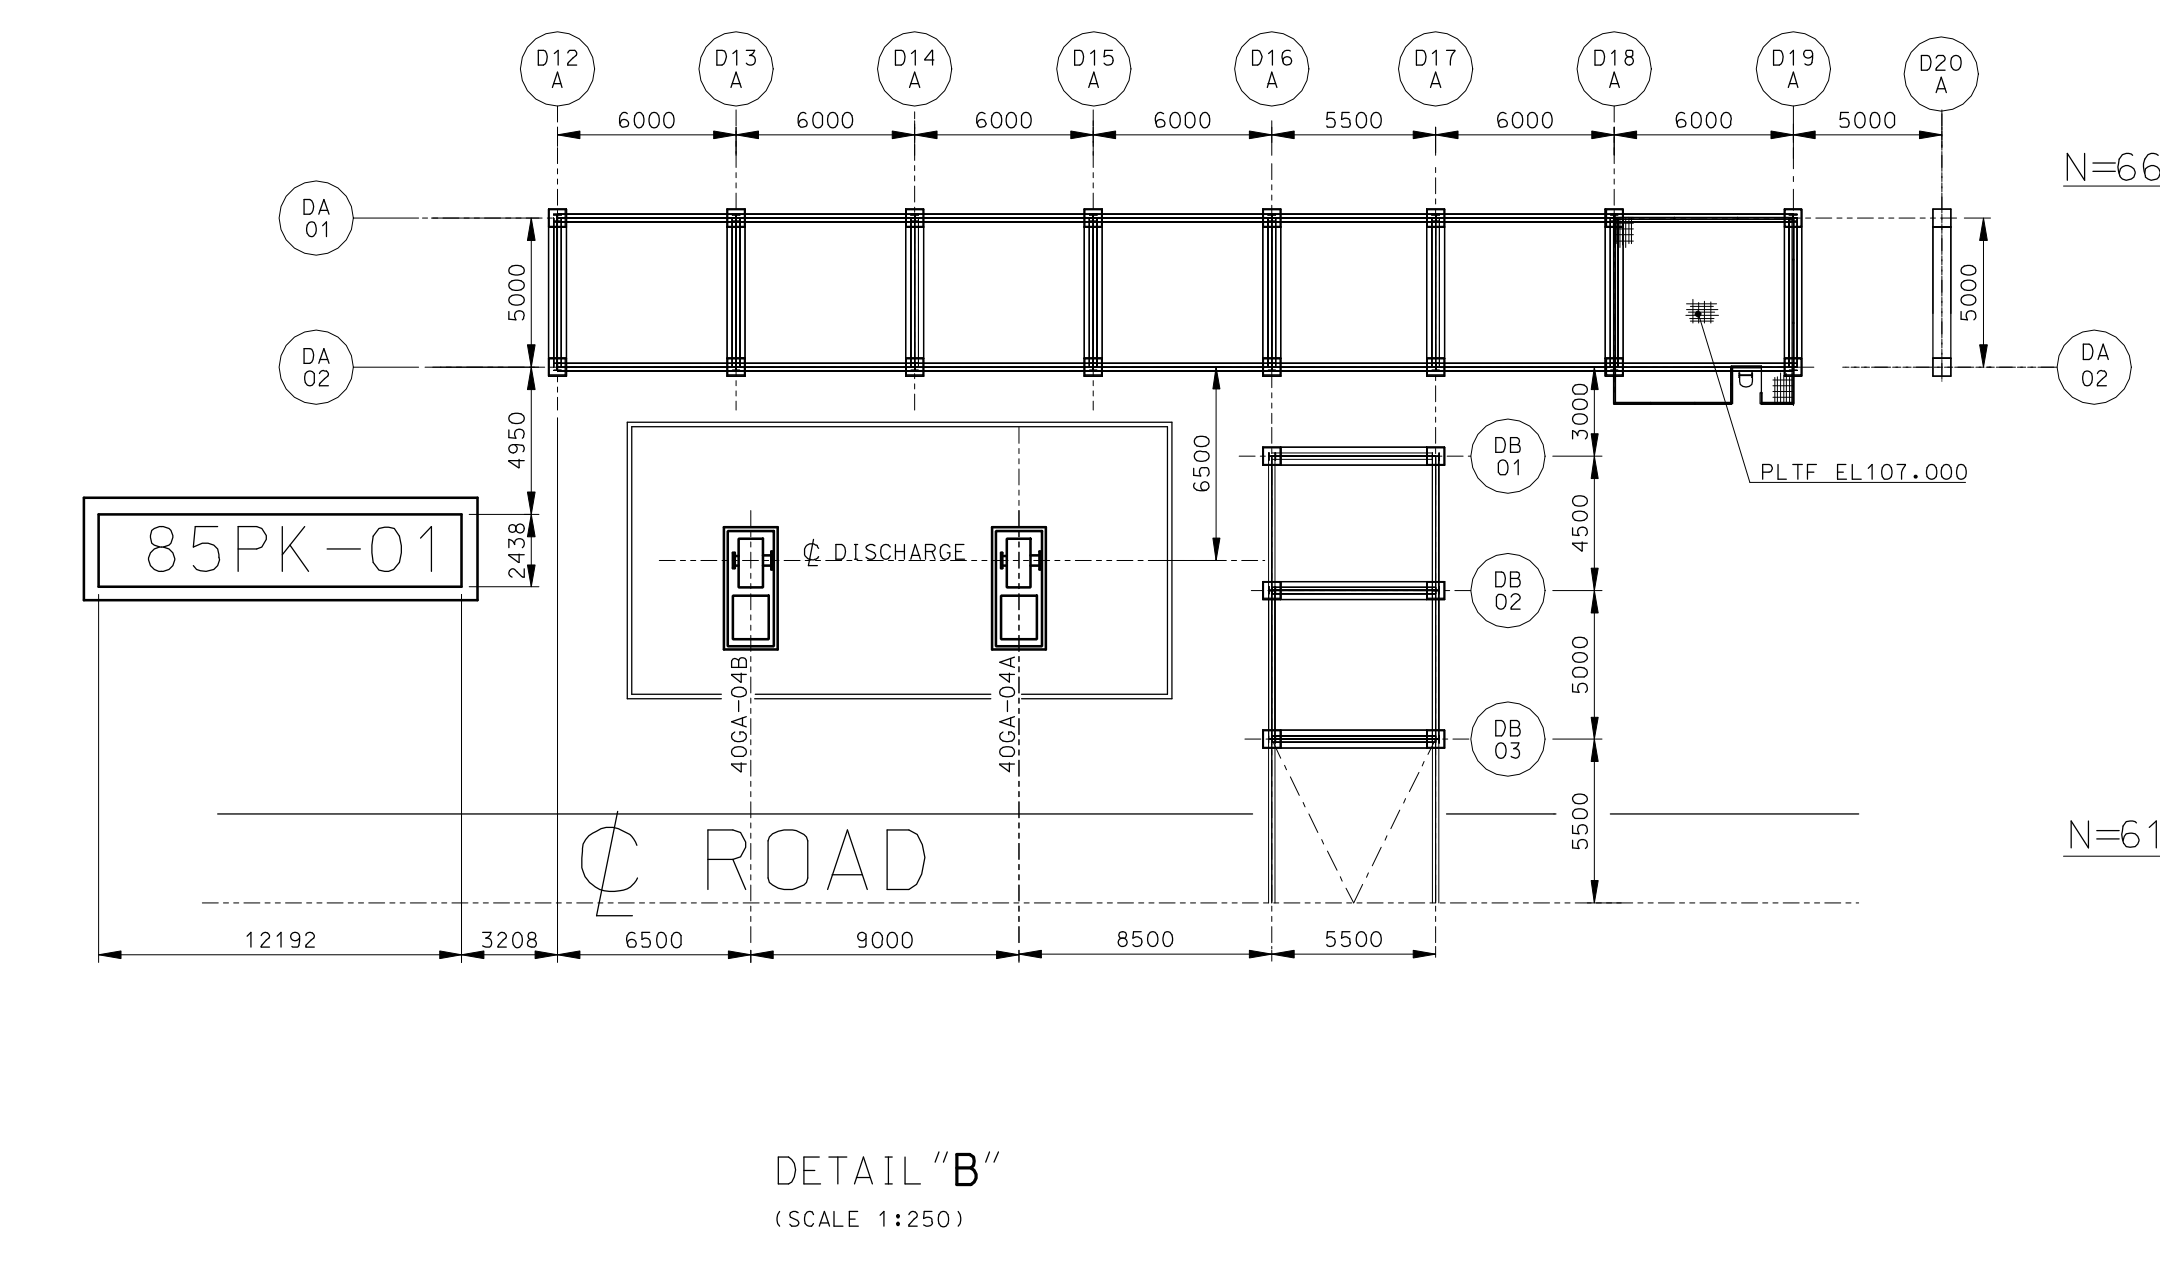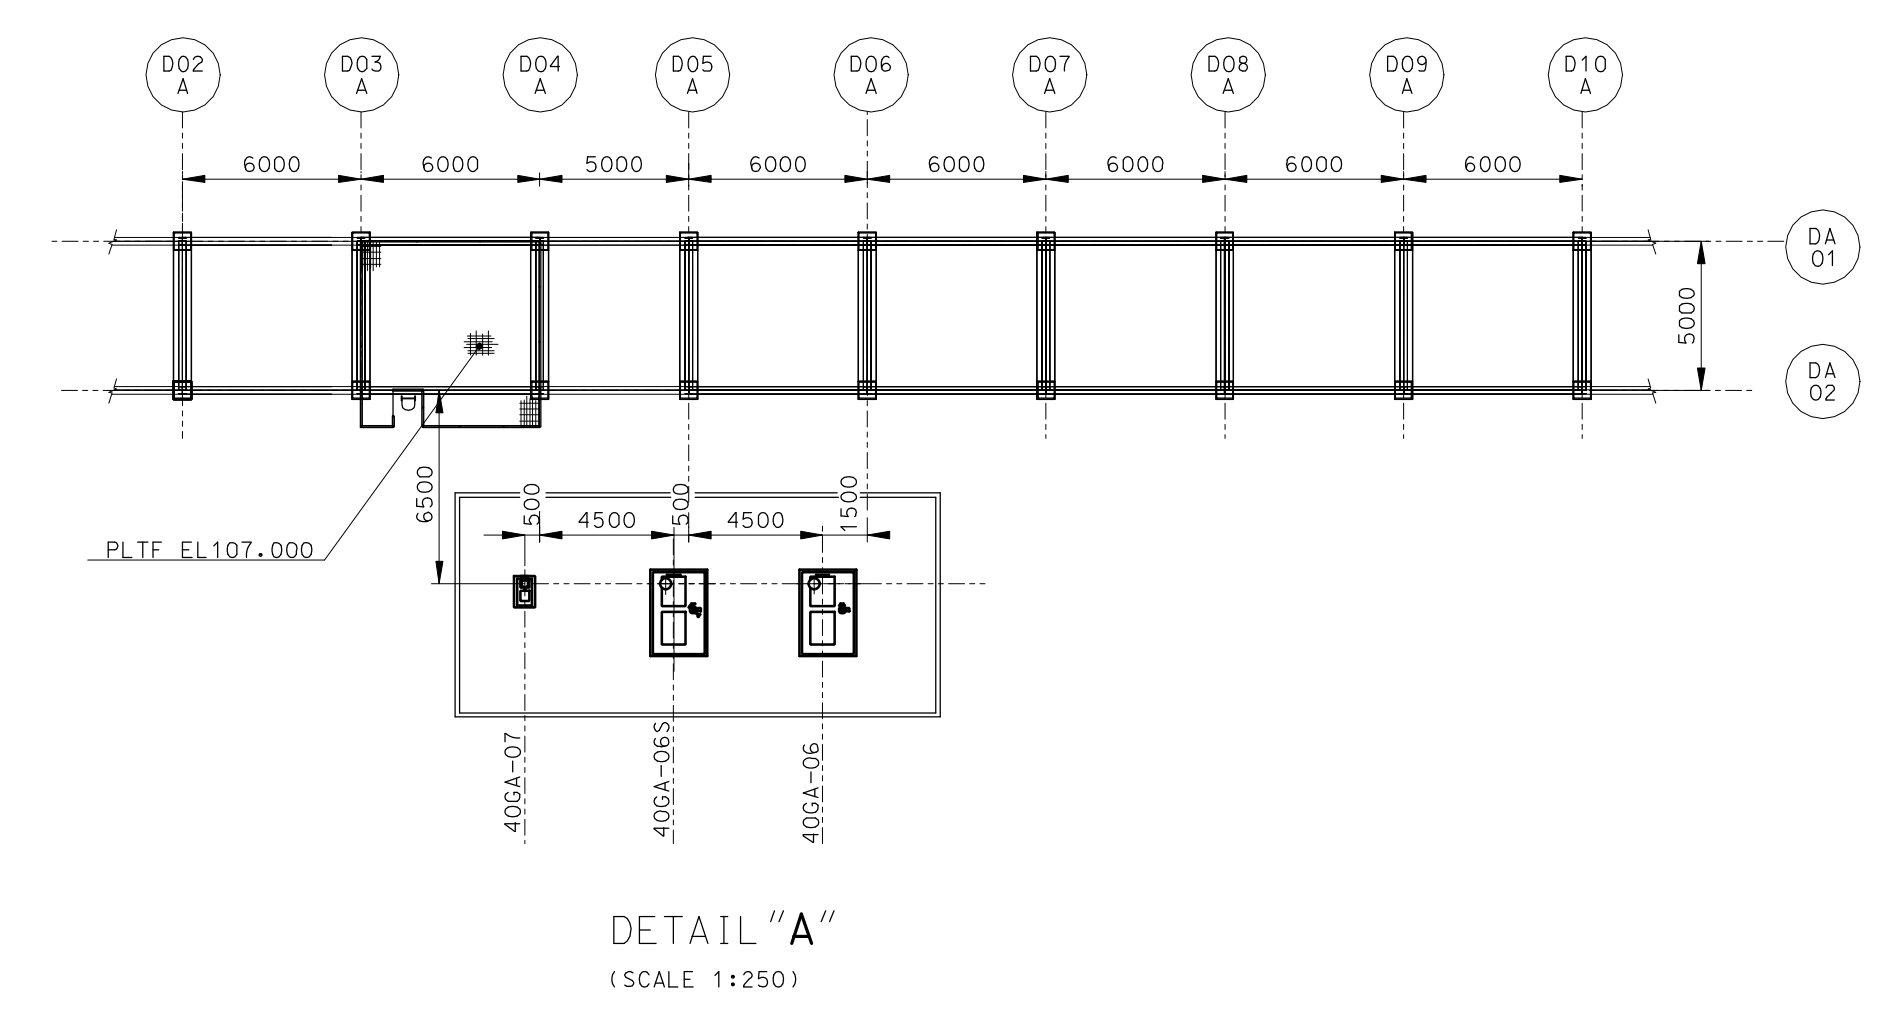

File name: 2305-000-04-1331-01_04.dgn
2305-04-01-REV.0A