


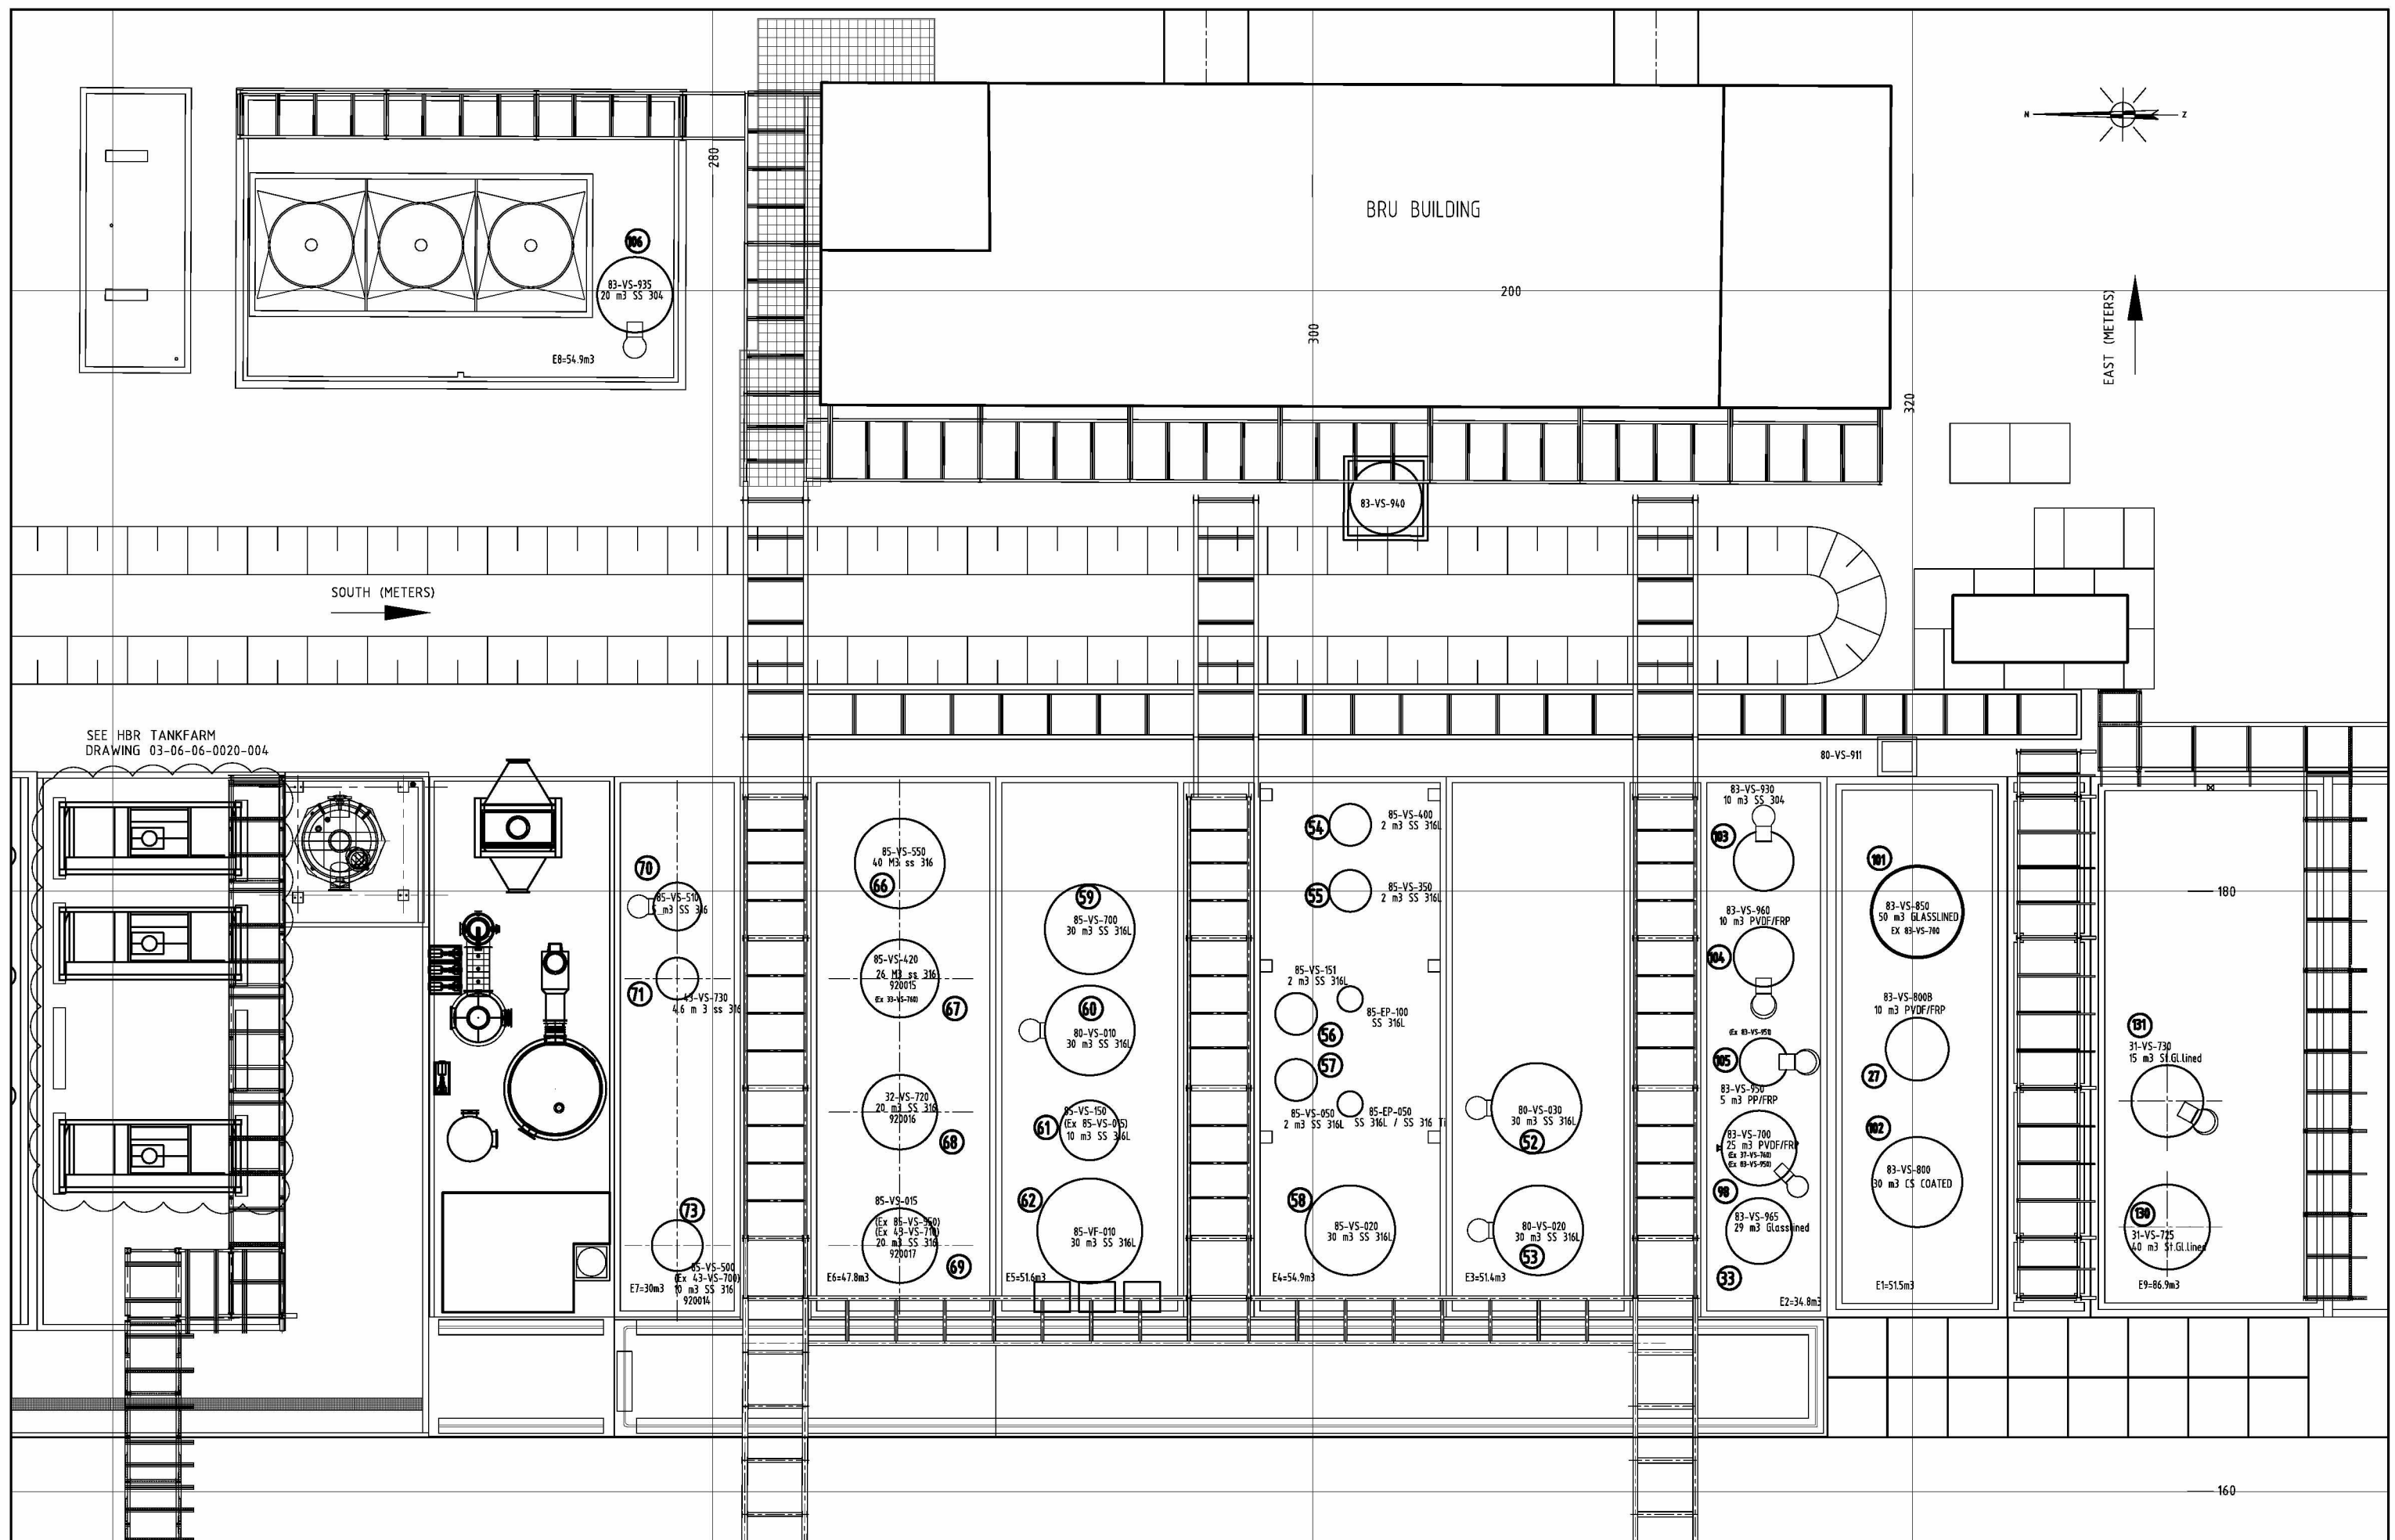

STATUS INSTALLATION	STATUS DRAWING	ENG. :	16	05-03-20	Updated the Netto Volume	I.S.											TITLE: STORAGE
		SCALE : 1:200	15	22-01-20	Add the volume of tankbak	IbSh											LAY-OUT
		DRAWN : 2E	14	29-07-19	Situation dd 29-07-2019	IbSh											GBC TANKFARM EAST
		CHKD. :	13	18-07-19	Update VOLUME TANK OF 85-VS-020	IbSh		1.7	18-12-20	Remove tanks 85-VS-103/153/360	I.S.						
Operative	As built	DATE : 01-12-94	REV.	DATE	DESCRIPTION	DRAWN	CHECKED	REV.	DATE	DESCRIPTION	DRAWN	CHECKED					

