


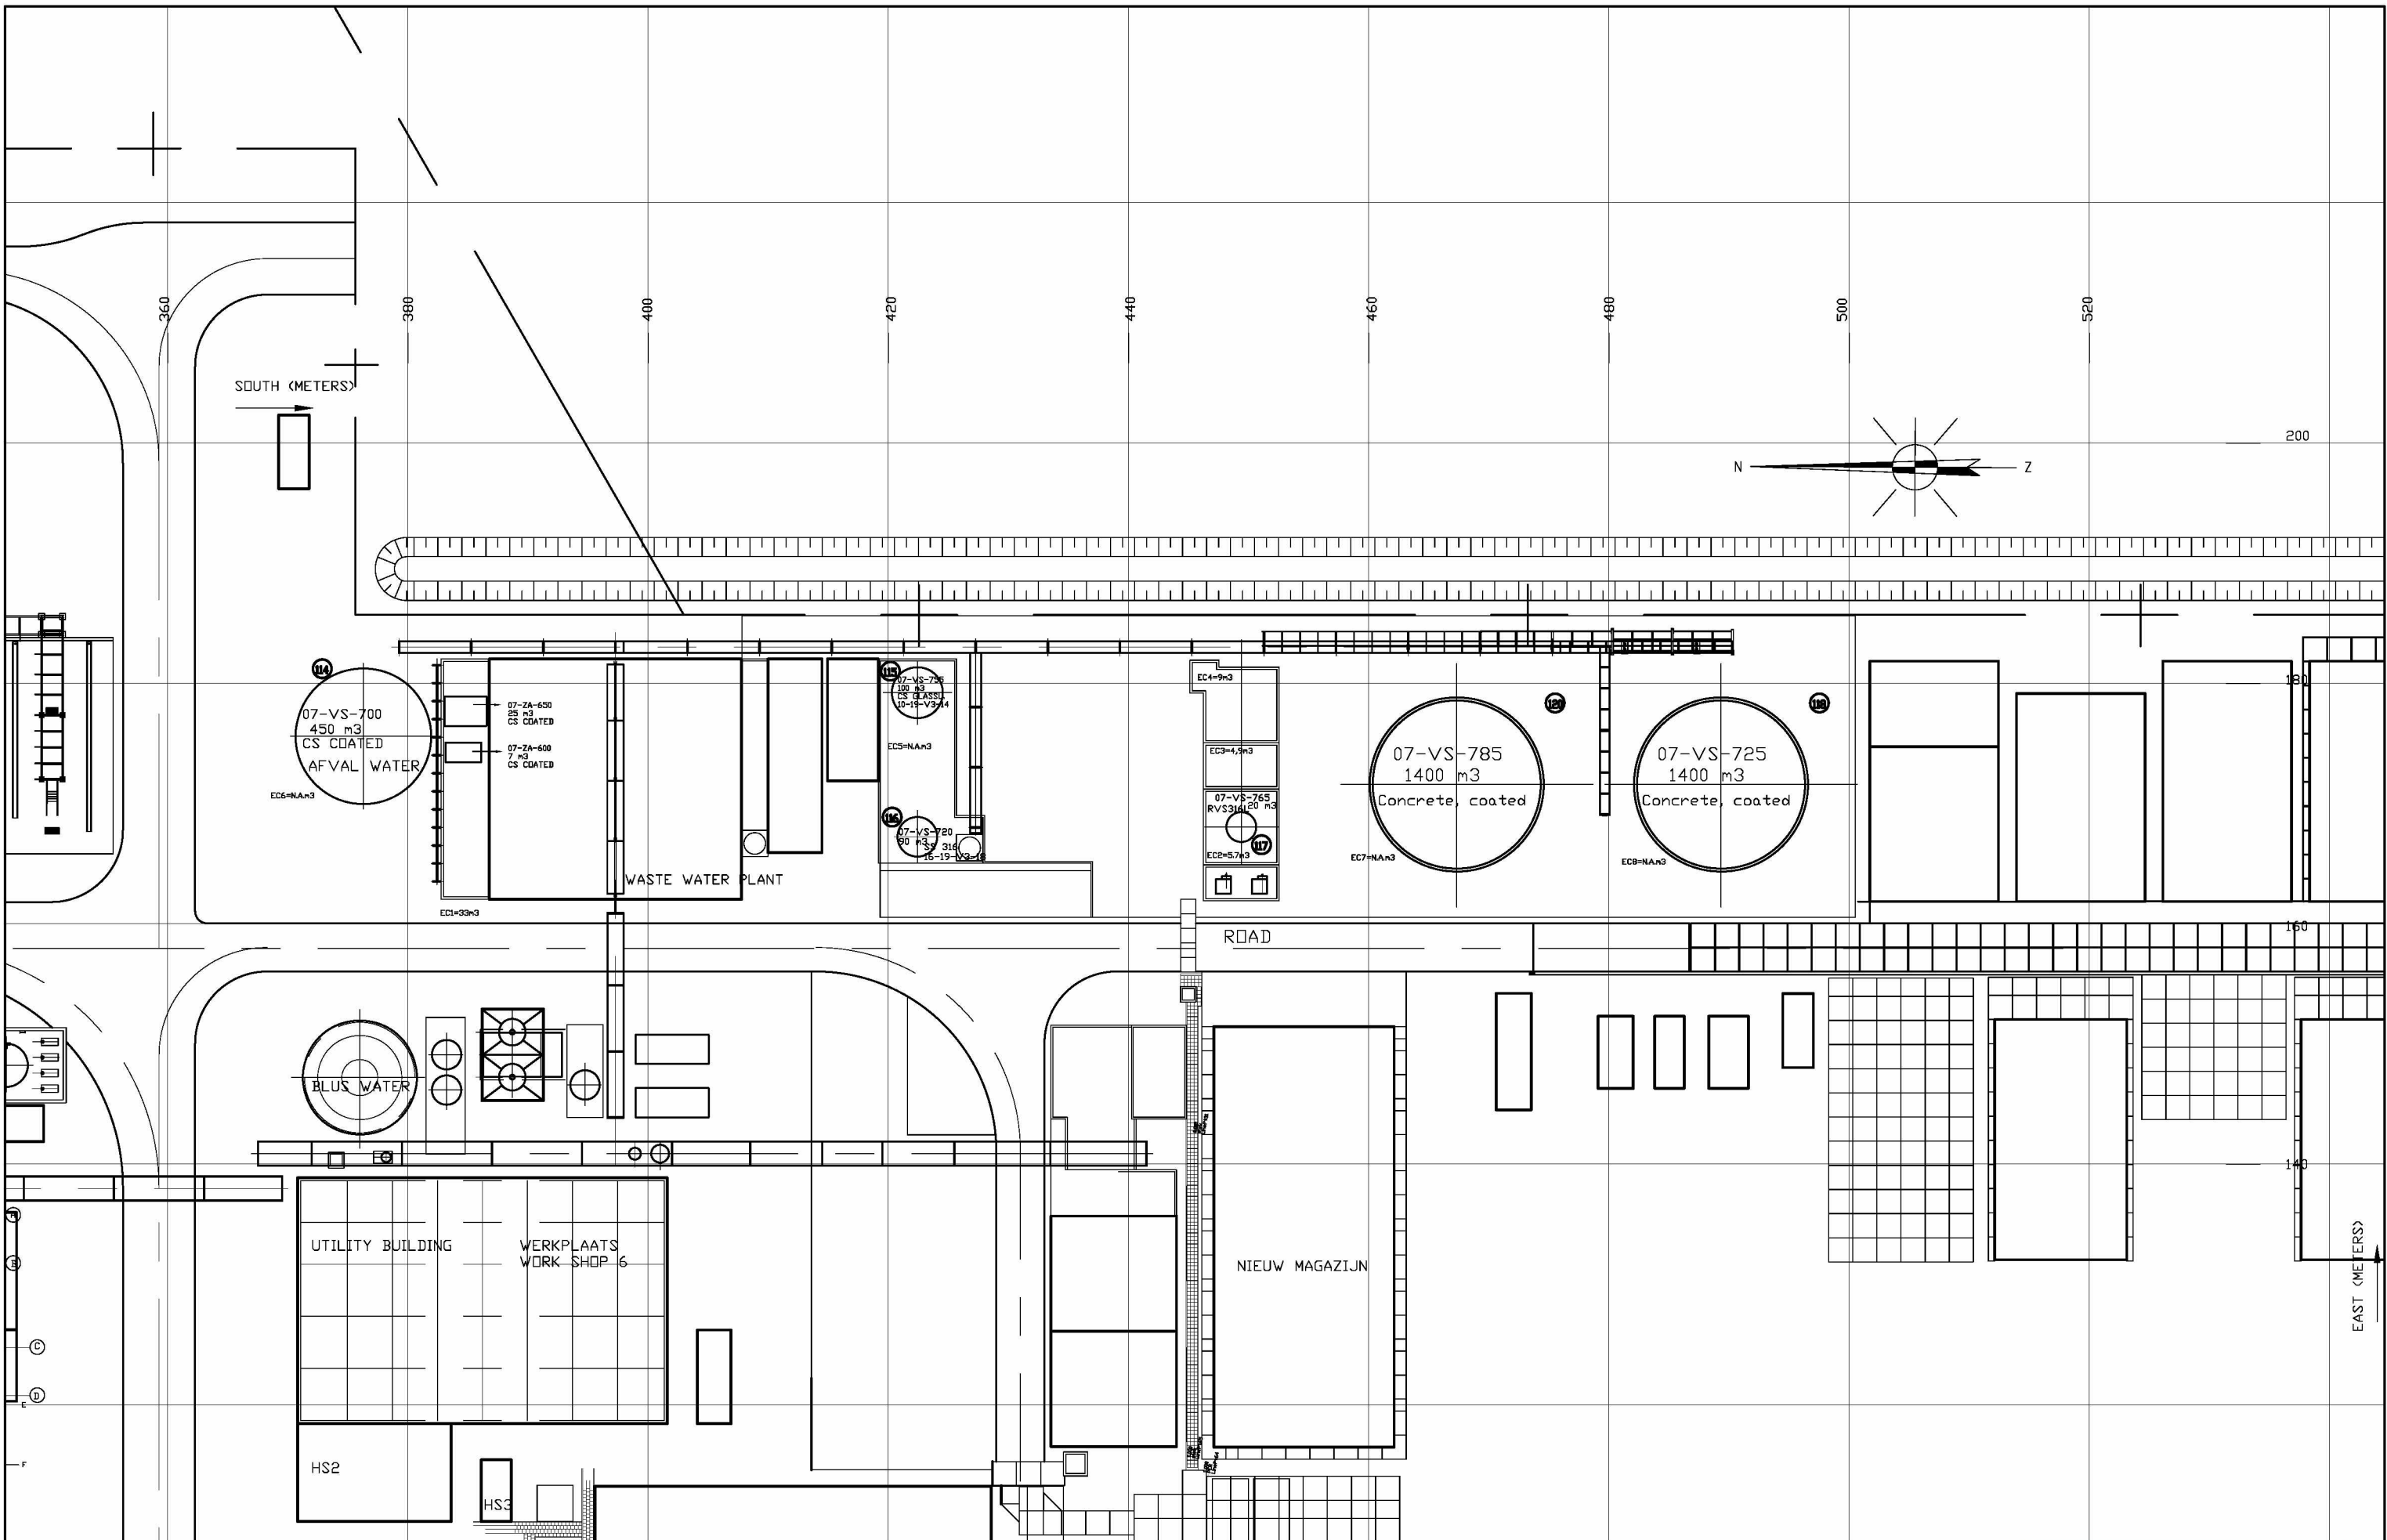

STATUS INSTALLATION Not existing Under construction Operative ☐ ☐ ☐	STATUS DRAWING For engineering For construction As built ☐ ☐ ☒	ENG. :	09	30-01-20	Update volume of EC5	I.S.										TITLE: Waste	AICL Industrial Products
		SCALE : 1:500	08	22-01-20	Remove tanks 07-VS-770/756	I.S.		12	04-11-20	Updated the tankput nmber	I.S.					Lay-out	
		DRAWN : 	07	28-09-18	Situation dd 28-09-18	E.B.		11	31-03-20	Updated the Netto Volume	I.S.					Location tanks	
		CHKD. :	06	09-06-17	Ecologie tanks updated	E.B.		10	05-03-20	Updated the Netto Volume	I.S.						
		DATE : 08-12-94	REV.	DATE	DESCRIPTION	DRAWN	CHECKED	REV.	DATE	DESCRIPTION	DRAWN	CHECKED	DWG Nr.: 03-16-19-0005-000		REV. Nr.: 12		