




STATUS INSTALLATION	STATUS DRAWING	ENG. :	04	22-01-20	Situation dd 22-01-2020	IbSh							TITLE:
		SCALE : 1:100	03	29-07-19	Situation dd 29-07-2019	IbSh	M.G.						
		DRAWN	02	28-09-18	Deminwater unit installed								
		CHKD. :	01	09-12-13	Processwater-/firewatertank = 15-VS-001 = 122			05	05-03-20	Updated the Netto Volume	I.S.		
		DATE :	REV.	DATE	DESCRIPTION	DRAWN	CHECKED	REV.	DATE	DESCRIPTION	DRAWN	CHECKED	
Not existing	For engineering												Layout
Under construction	For construction												Utility building East side
Operative	As built												DWG Nr.:03-03-0C-0010-000REV. Nr.: 05

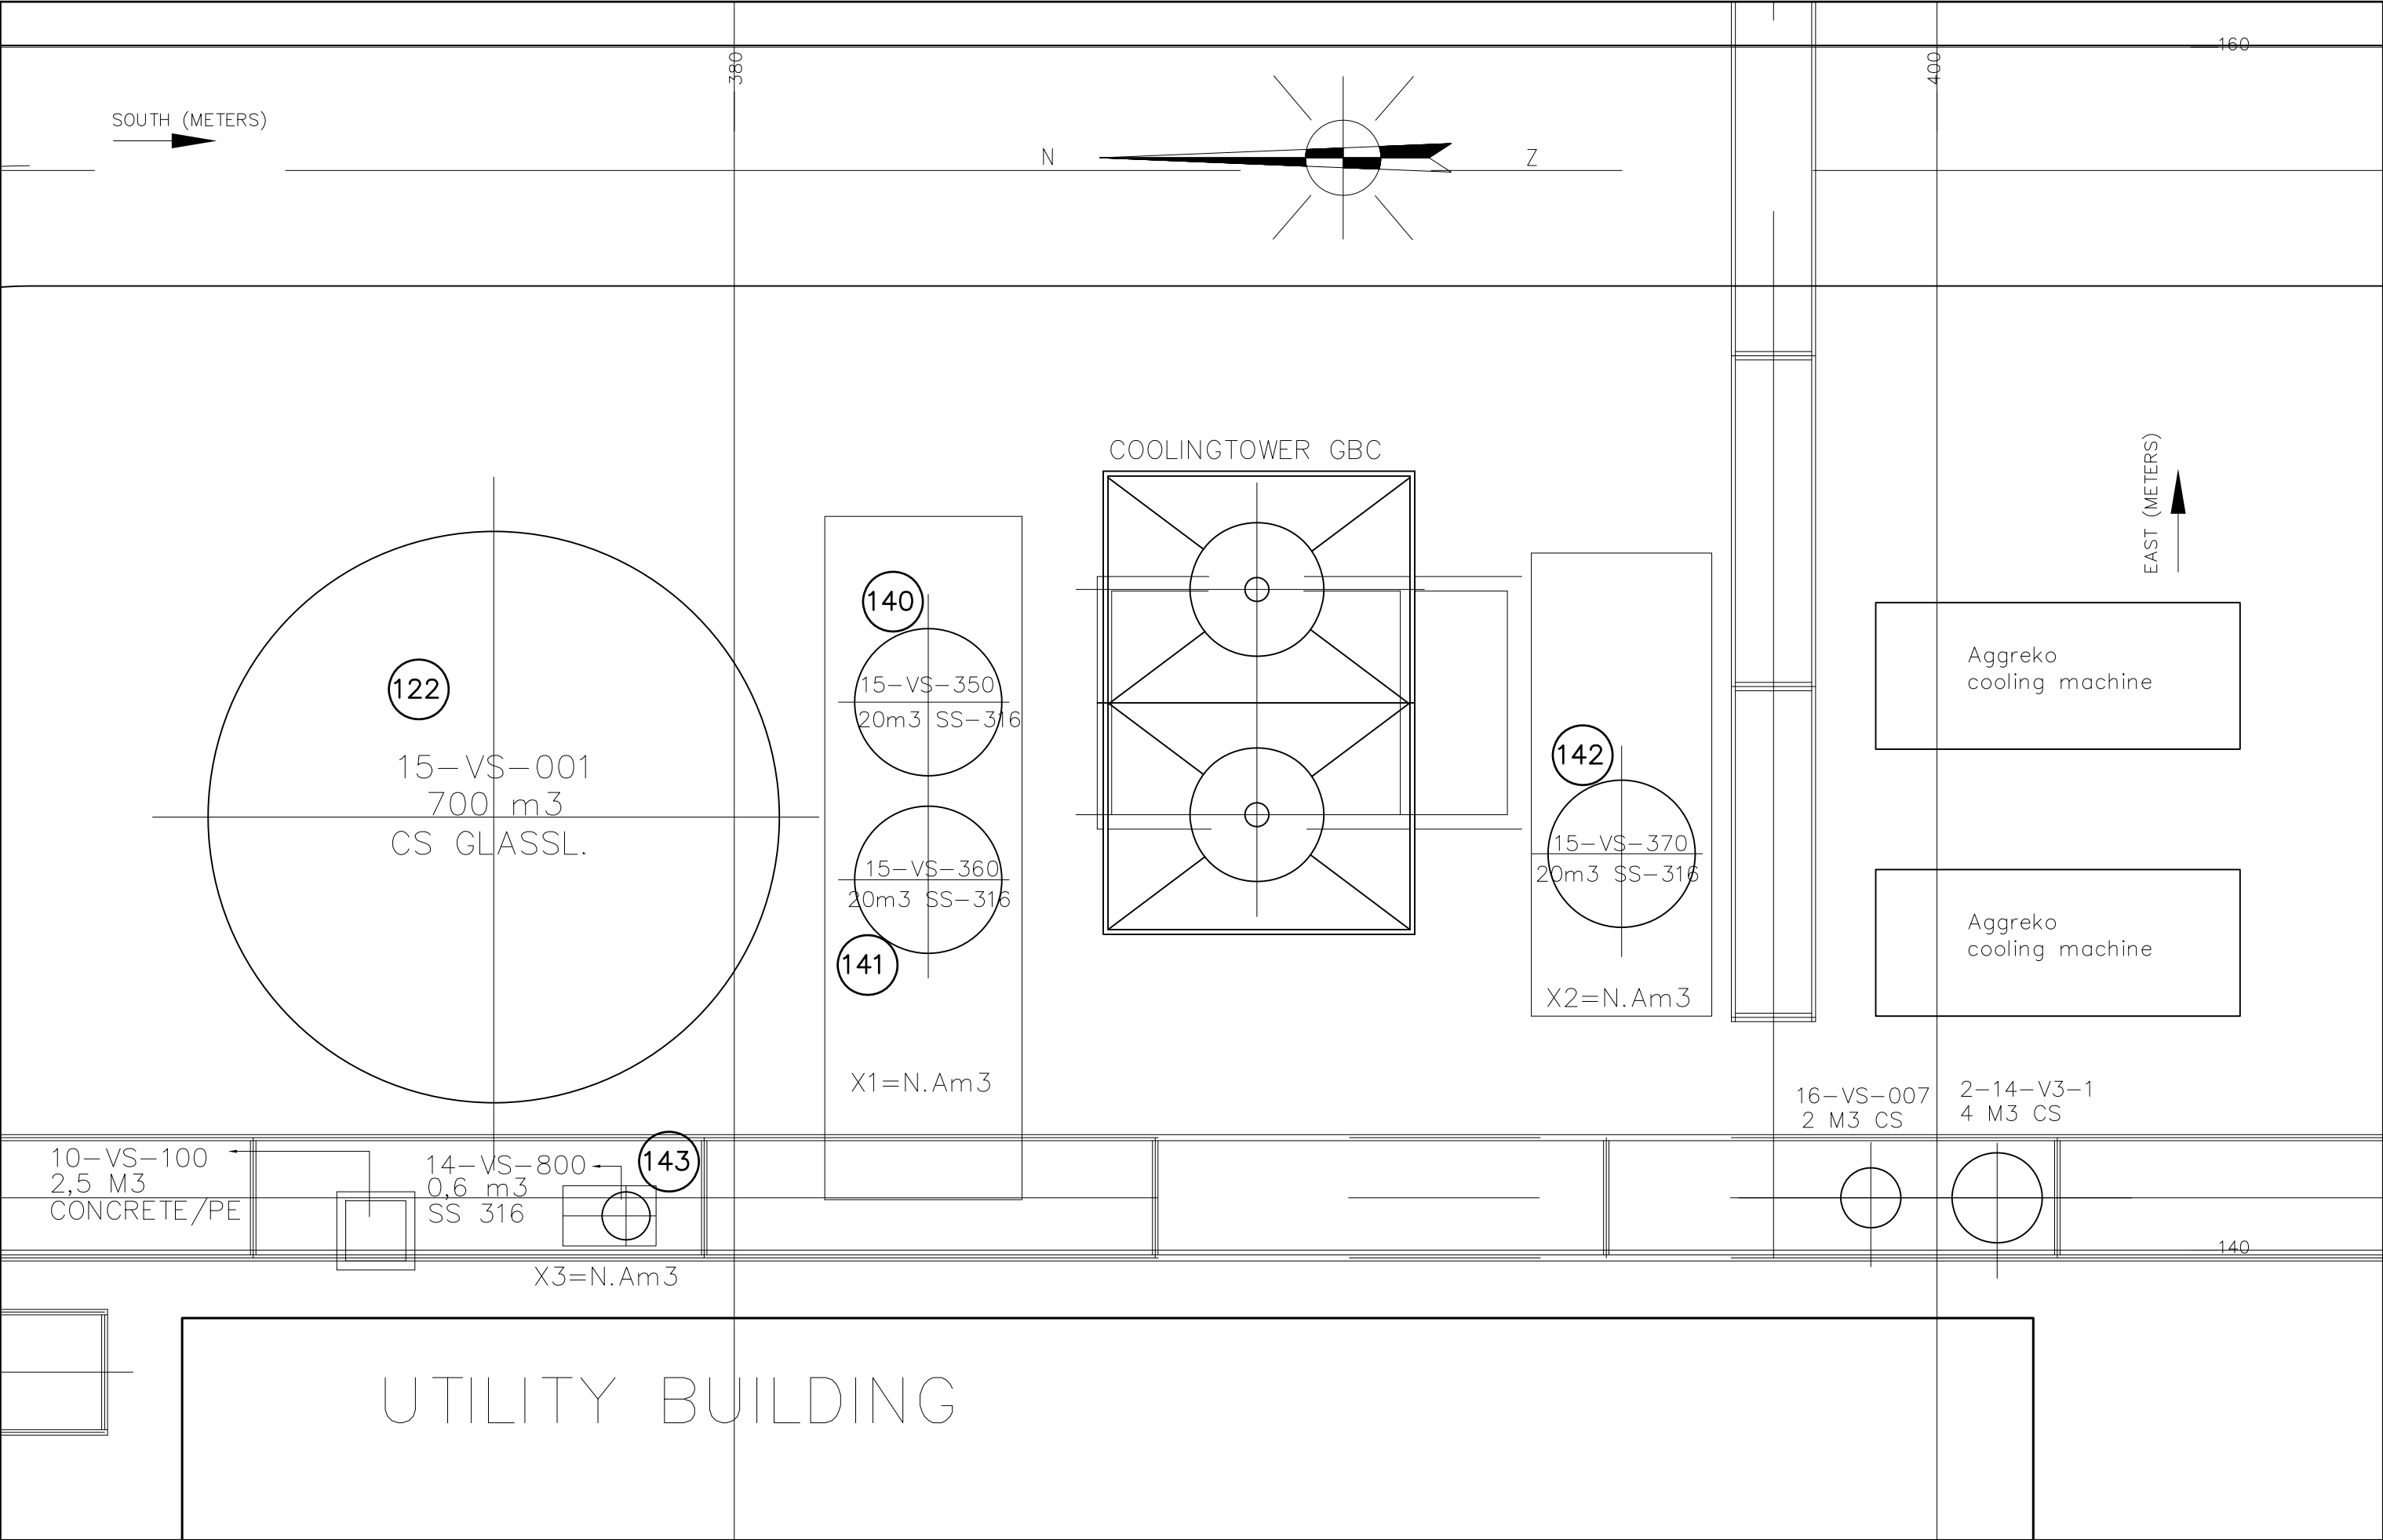