

ALGEMEEN


Meetniveau
 - Begane grond 0 is gelijk aan Peil = +100.000 (ca. 1500 mm + N.A.P.)
 - 1e verdieping 6.950+ meetniveau
 - 2e verdieping 15.000+ meetniveau
 - 3e verdieping 21.700+ meetniveau

Gebruiksoppervlak per Gebruiksfunctie

| Industriefunctie | Oppervlakte |
|------------------|----------------------|
| begane grond | 11682 m ² |
| 1e verdieping | 5554 m ² |
| 2e verdieping | 4533 m ² |
| 3e verdieping | 1006 m ² |
| Totaal | 22775 m ² |

| Kantoorfunctie | Oppervlakte |
|----------------|---------------------|
| begane grond | 5 m ² |
| 1e verdieping | 1896 m ² |
| 2e verdieping | 0 m ² |
| 3e verdieping | 0 m ² |
| Totaal | 1901 m ² |

Inrichting
 Volgens art. 2.12.2 lid 4d van het Bouwbesluit is de inrichting en opstelling van de inventaris aangegeven bij meer dan 25 personen per ruimte.
 De maximale bezetting van die ruimtes is aangegeven in die desbetreffende ruimte.

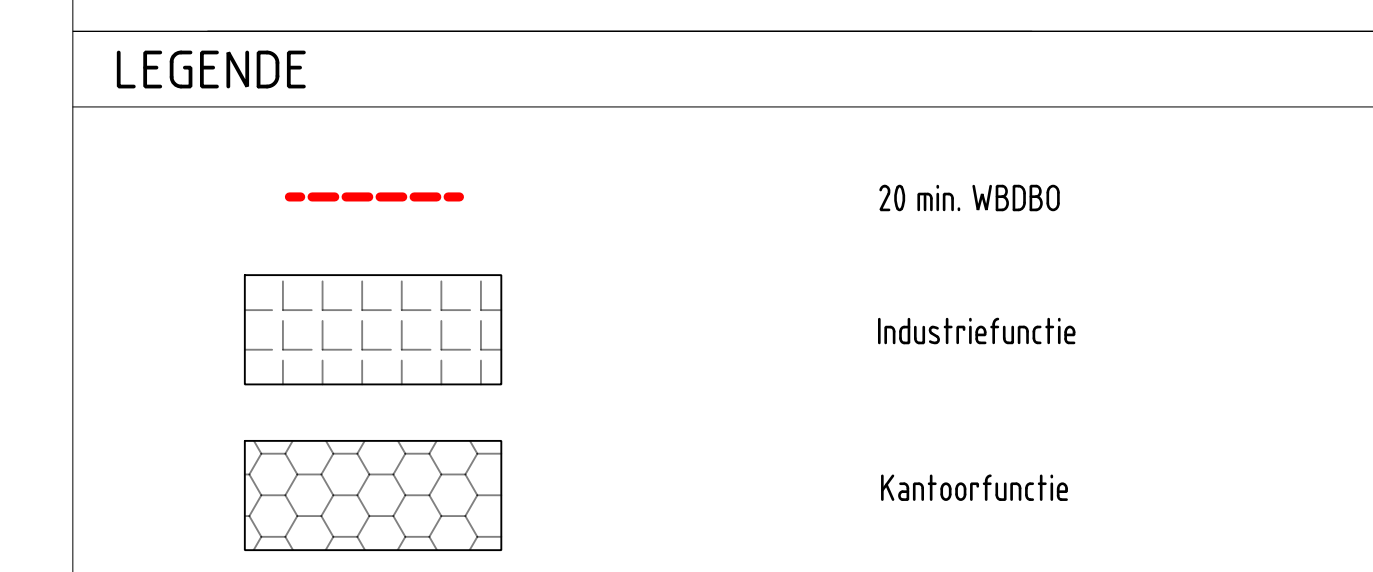

BRANDCOMPARTIMENTEN

| Compartment | Kleur | Oppervlakte |
|-------------|----------------|---------------------|
| 1 | [Light Blue] | 18529m ² |
| 2 | [Purple] | 3834m ² |
| 3 | [Light Green] | 30m ² |
| 4 | [Dark Blue] | 31m ² |
| 5 | [Pink] | 190m ² |
| 6 | [Brown] | 204m ² |
| 7 | [Light Purple] | 81m ² |
| Totaal | | 24676m ² |

| REV. NO. | PROJECT NO. | DESCRIPTION | DATE | DRWN | CHKD | APPR |
|----------|-------------|-------------|------|------|------|------|
| 001 | mm29070 | AS BUILT | 2/24 | VeS | DeM | DeM |

REVISIONS

SCALE 1/200 GRAPHIC SCALE

STAMP

THIS DRAWING OR PRINT IS THE PROPERTY OF SABIC AND IS TO BE USED ONLY CONFIDENTIALLY BY AUTHORIZED PERSONNEL. IT SHALL NOT BE COPIED, REPRODUCED NOT EXHIBITED TO UNAUTHORIZED PERSONS AND IS TO BE RETURNED UPON REQUEST.

TITLE **Passieve Brandbeveiliging Lexaan Begane Grond**



| | | |
|------------|----|------------|
| CONTRACTOR | BY | DATE |
| mm29070 | | 27.02.2024 |

| | | |
|-------------|----------------------|------|
| PROJECT NO. | DWG. NO. | REV. |
| mm29070 | 400-GX-001100.sh.001 | 001 |

SABIC_5027_m_20.dwg