

ALGEMEEN


Meetniveau
 - Begane grond 0 is gelijk aan Peil = +100.000 (ca. 1500 mm + N.A.P.)
 - 1e verdieping 6.950+ meetniveau
 - 2e verdieping 15.000+ meetniveau
 - 3e verdieping 21.700+ meetniveau

Gebruiksoppervlak per Gebruiksfunctie

Industriefunctie	
begane grond	11682 m ²
1e verdieping	5554 m ²
2e verdieping	4533 m ²
3e verdieping	1006 m ²
Totaal	22775 m ²

Kantoorfunctie	
begane grond	5 m ²
1e verdieping	1896 m ²
2e verdieping	0 m ²
3e verdieping	0 m ²
Totaal	1901 m ²

Inrichting
 Volgens art. 2.12.2 lid 4d van het Bouwbesluit is de inrichting en opstelling van de inventaris aangegeven bij meer dan 25 personen per ruimte.
 De maximale bezetting van die ruimtes is aangegeven in die desbetreffende ruimte.

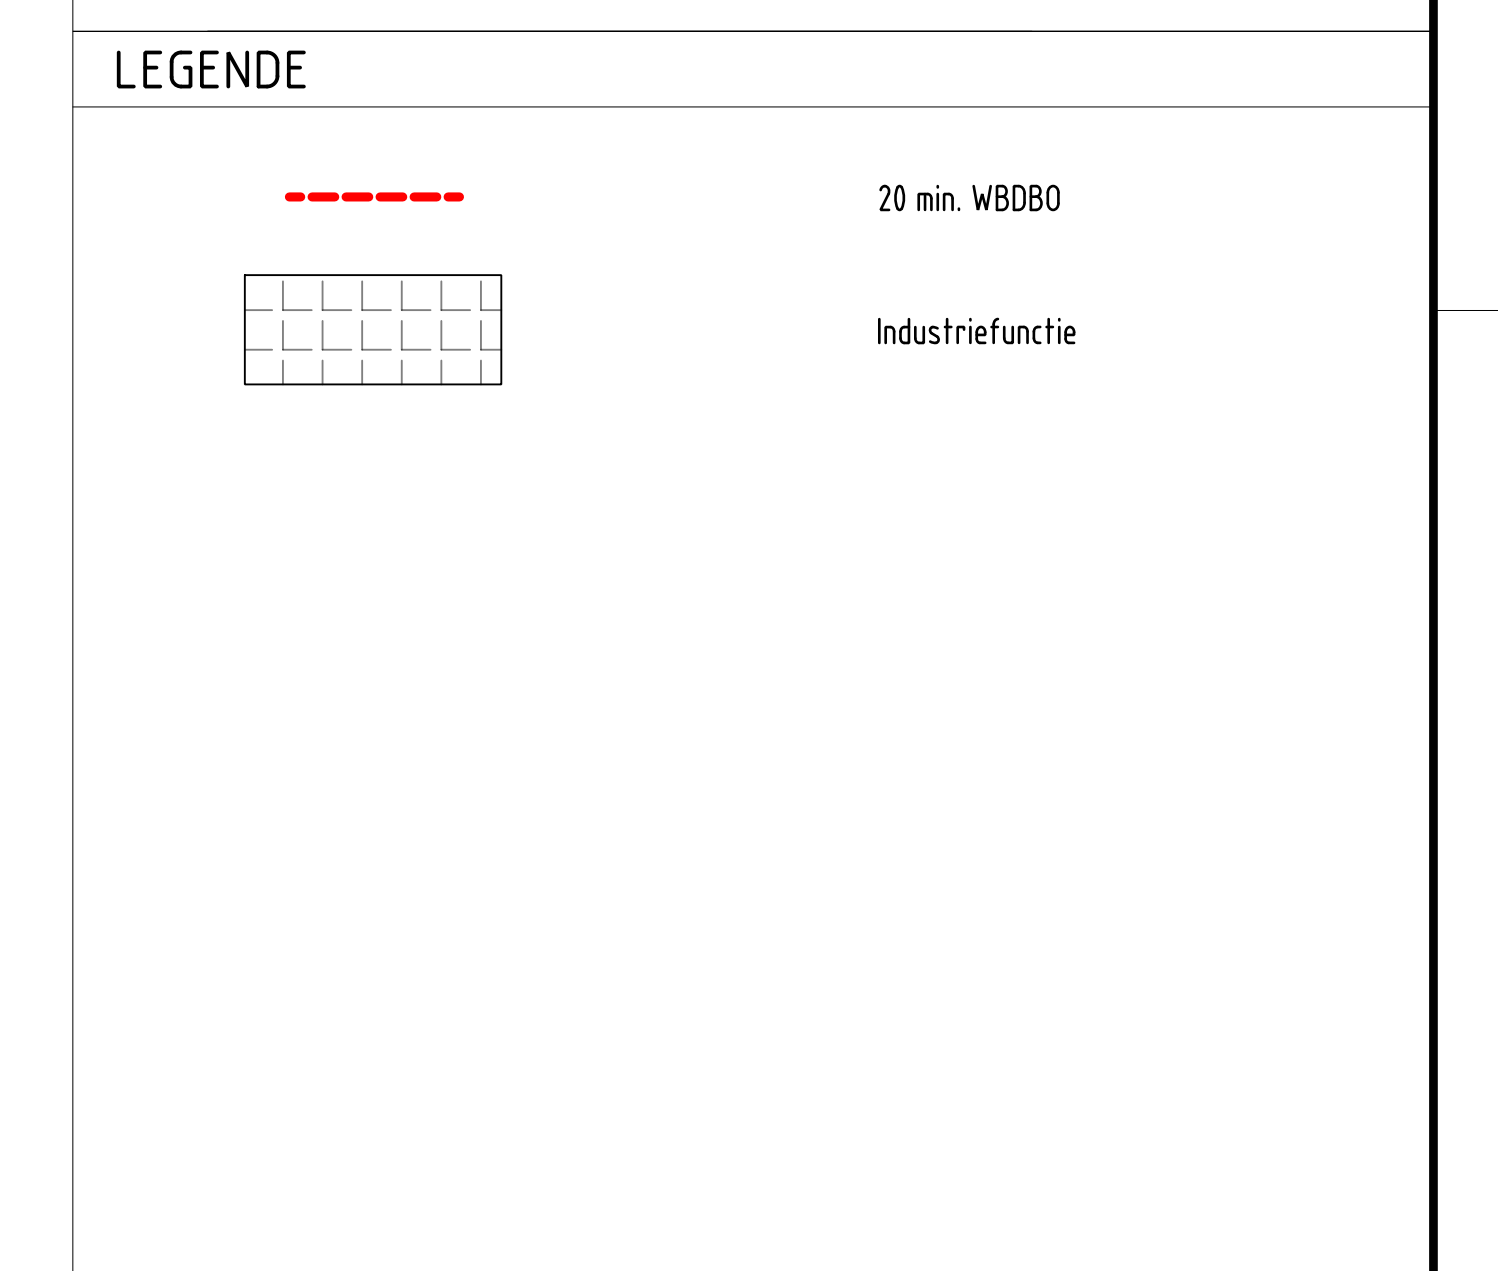

BRANDCOMPARTIMENTEN

Compartment	Kleur	Oppervlakte
1		18529m ²
2		3834m ²
3		30m ²
4		31m ²
5		1901m ²
6		204m ²
7		81m ²
Totaal		24676m ²

REV. NO.	PROJECT NO.	DESCRIPTION	DATE	DRWN	CHKD	APPR
001	mm29070	AS BUILT	2/24	VeS	DeM	DeM

SCALE 1/200 GRAPHIC SCALE

STAMP

THIS DRAWING OR PRINT IS THE PROPERTY OF SABIC AND IS TO BE USED ONLY CONFIDENTIALLY BY AUTHORIZED PERSONNEL. IT SHALL NOT BE COPIED, REPRODUCED NOR EXHIBITED TO UNAUTHORIZED PERSONS AND IS TO BE RETURNED UPON REQUEST.

TITLE **Passieve Brandbeveiliging Lexaan 2e Verdieping**



CONTRACTOR BY DATE 27.02.2024

PROJECT NO.	DWG. NO.	REV.
mm29070	400-GX-001100.sh.003	001

SABIC_5027_N_20.dwg