


ALGEMEEN

- Meetniveau
 - Begane grond 0 is gelijk aan Peil = +100.000 (ca. 1500 mm + N.A.P.)
 - 1e verdieping 6.950+ meetniveau
 - 2e verdieping 15.000+ meetniveau
 - 3e verdieping 21.700+ meetniveau
- Gebruiksoppervlak per Gebruiksfunctie
- | | |
|------------------|----------------------|
| Industriefunctie | |
| begane grond | 11682 m ² |
| 1e verdieping | 5554 m ² |
| 2e verdieping | 4533 m ² |
| 3e verdieping | 1006 m ² |
| Totaal | 22775 m ² |
- | | |
|----------------|---------------------|
| Kantoorfunctie | |
| begane grond | 5 m ² |
| 1e verdieping | 1836 m ² |
| 2e verdieping | 0 m ² |
| 3e verdieping | 0 m ² |
| Totaal | 1901 m ² |

Inrichting
 Volgens art. 2.12.2 lid 4d van het Bouwbesluit is de inrichting en opstelling van de inventaris aangegeven bij meer dan 25 personen per ruimte.
 De maximale bezetting van die ruimtes is aangegeven in die desbetreffende ruimte.

LEGENDE

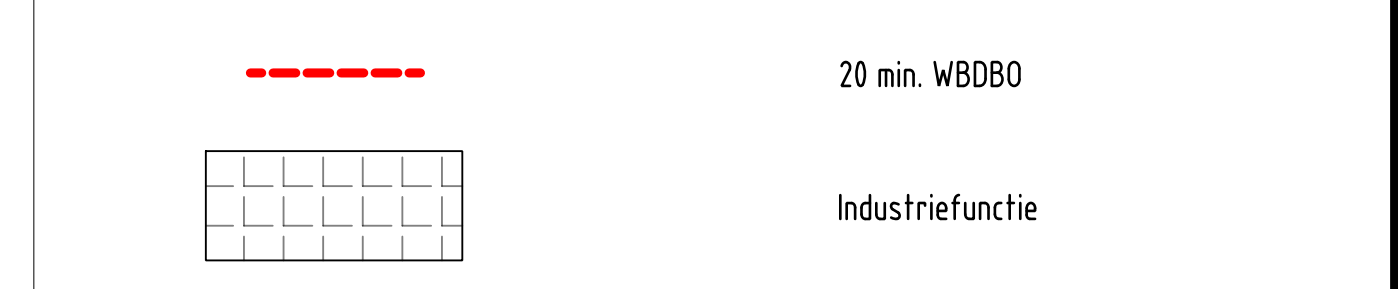

BRANDCOMPARTIMENTEN		
Compartment	Kleur	Oppervlakte
1	[Light Blue]	18529m ²
2	[Purple]	3834m ²
3	[Light Green]	30m ²
4	[Dark Blue]	31m ²
5	[Pink]	1901m ²
6	[Brown]	204m ²
7	[Light Purple]	81m ²
Totaal		24678m ²

001	mm29070	AS BUILT	2/24	VeS	DaM	DaM
REV. NO.	PROJECT NO.	DESCRIPTION	DATE	DRWN	CHKD	APPR

SCALE 1/200 GRAPHIC SCALE

STAMP

THIS DRAWING OR PRINT IS THE PROPERTY OF SABIC AND IS TO BE USED ONLY CONFIDENTIALLY BY AUTHORIZED PERSONNEL. IT SHALL NOT BE COPIED, REPRODUCED NOR EXHIBITED TO UNAUTHORIZED PERSONS AND IS TO BE RETURNED UPON REQUEST.

TITLE **Passieve Brandbeveiliging**
Lexaan
3e Verdieping



CONTRACTOR BY DATE 27.02.2024

PROJECT NO.	DWG. NO.	REV.
mm29070	400-GX-001100.sh.004	001

SABIC_5027_N_30.dwg