


THIS DRAWING REMAINS THE PROPERTY OF HOST AND MUST BE NEITHER BE PASSED ON TO ANY PERSON NOT AUTHORIZED BY US TO RECEIVE IT, NOR BE COPIED OR OTHERWISE MADE USE OF ANYBODY WITHOUT OUR PERMISSION.

No.	Description	Remarks
1	CO2 Liquefaction container	45 ft
2	Carbon filter	1 m3
3	CO2 reboiler skid	-
4	CO2 storage tank	2x 50 m3
5	Filling station	-

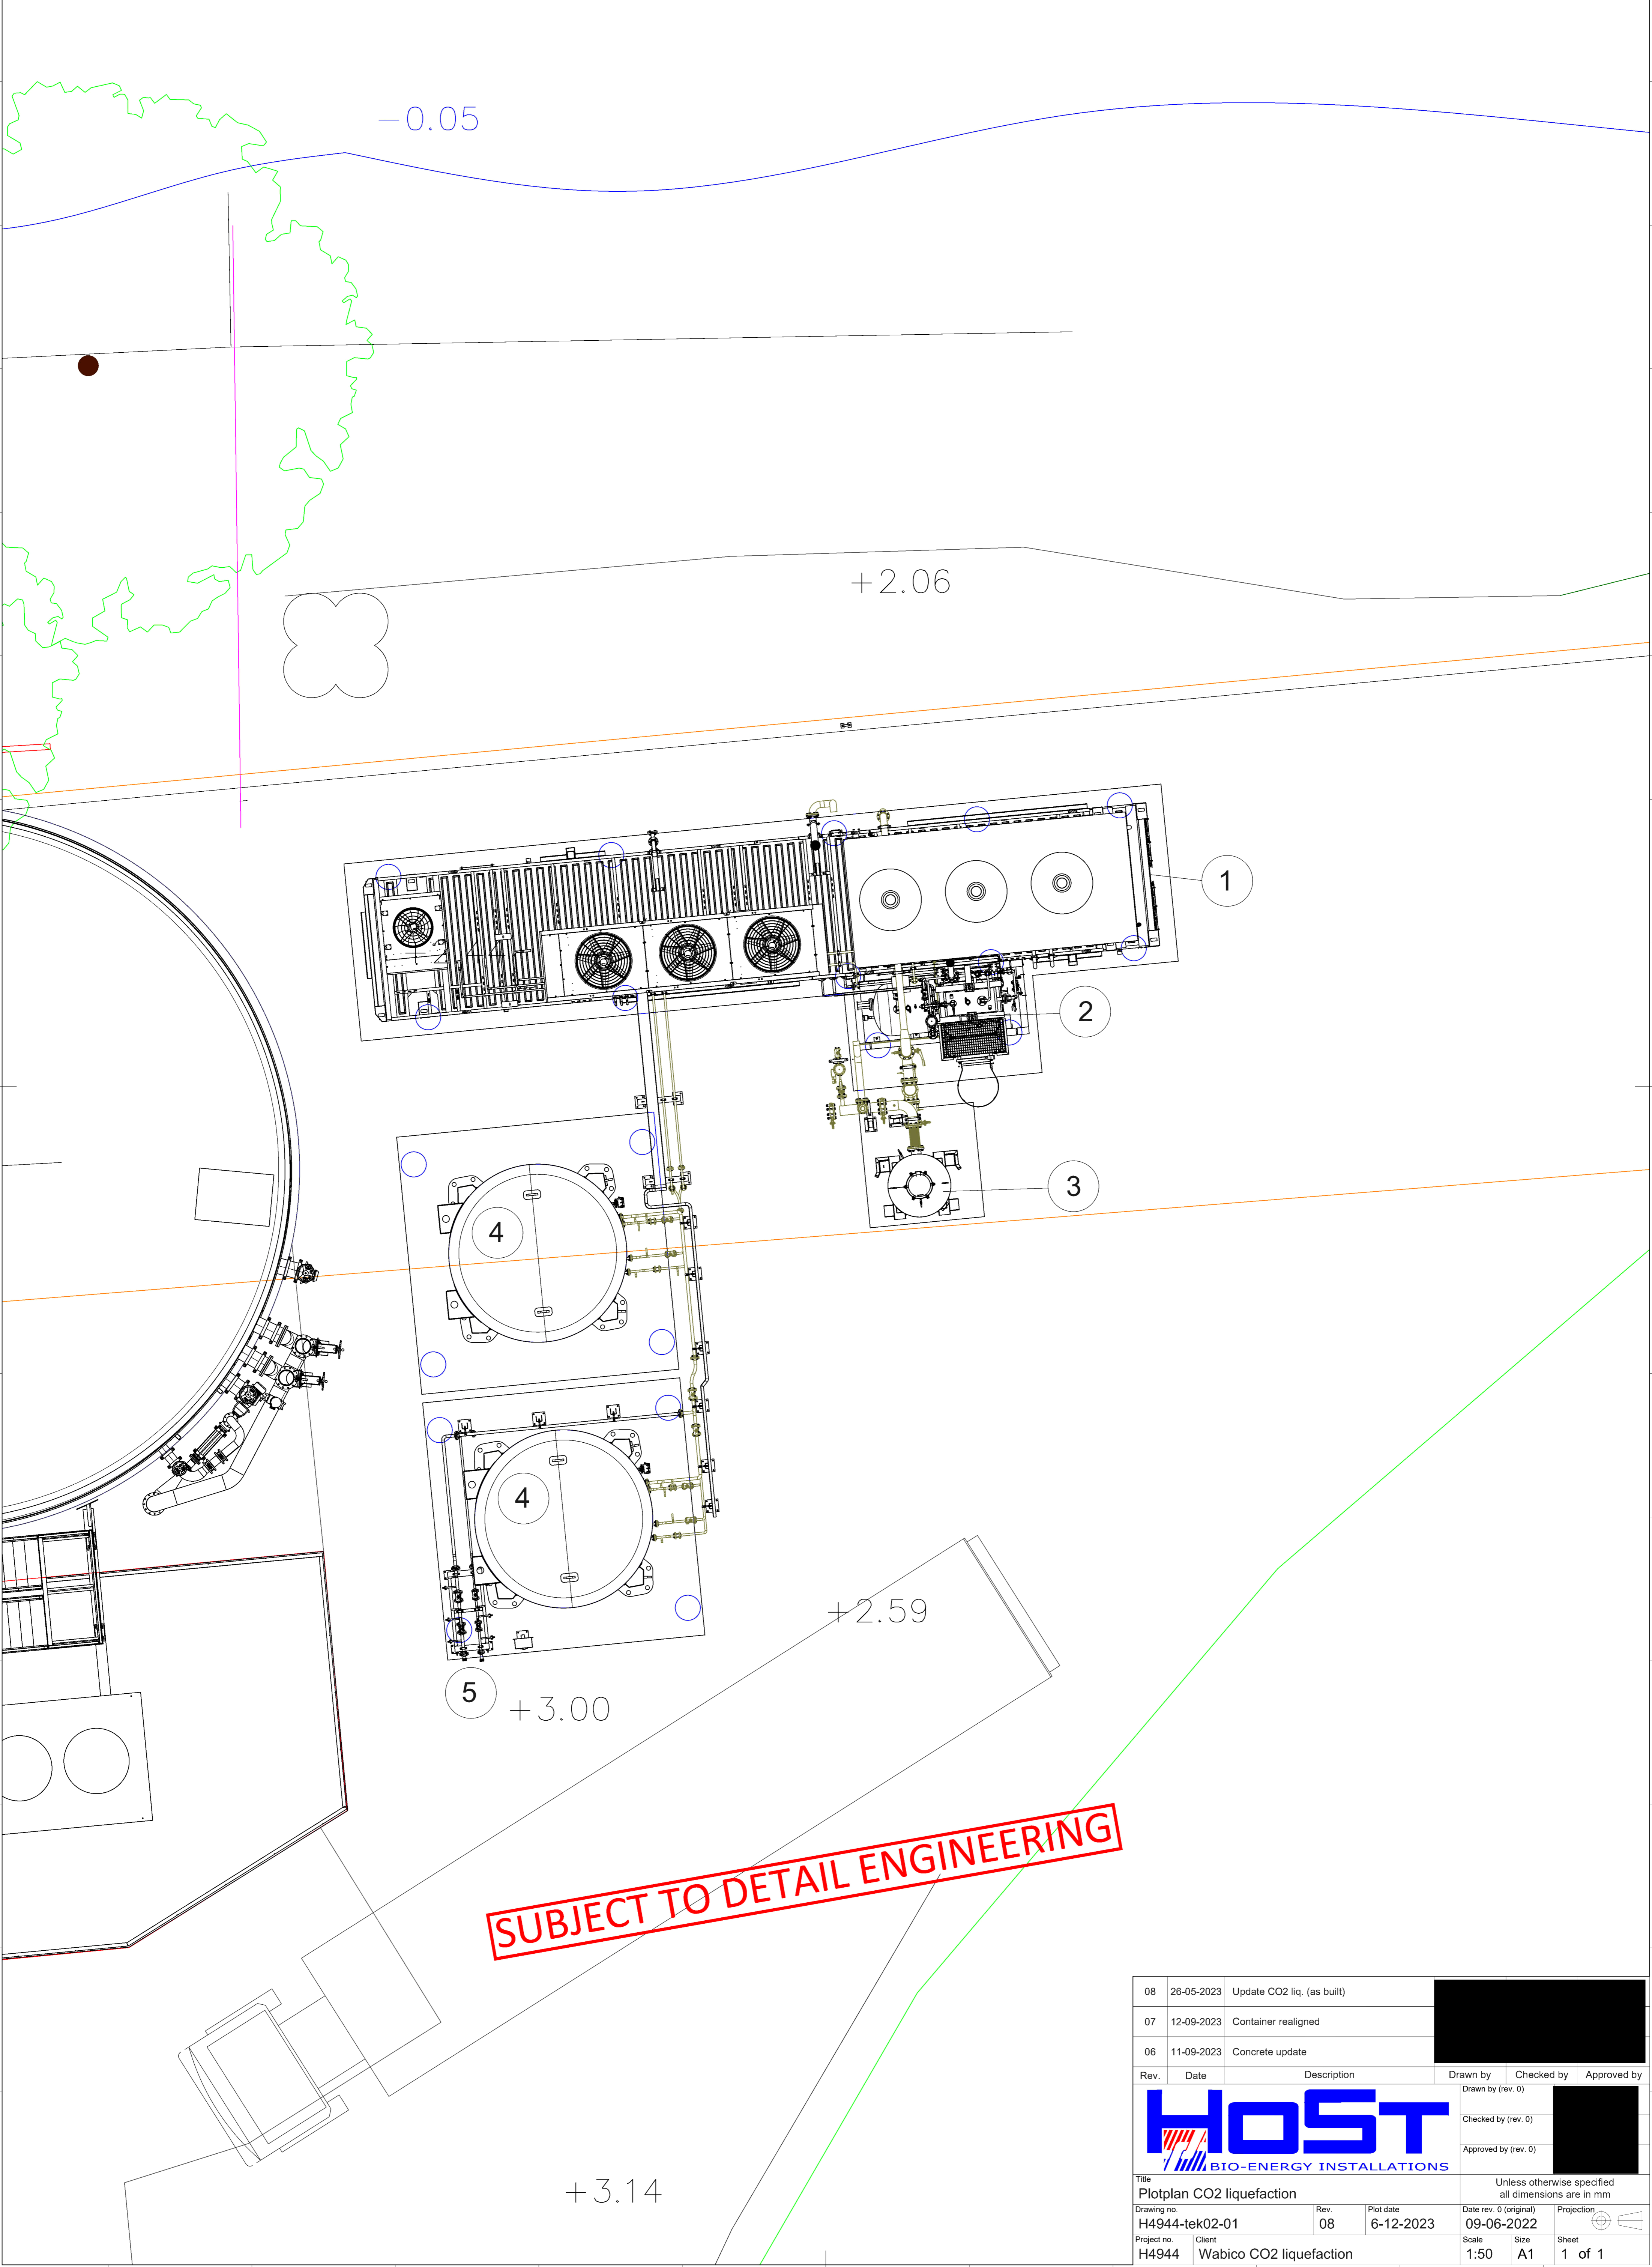

08	26-05-2023	Update CO2 liq. (as built)			
07	12-09-2023	Container realigned			
06	11-09-2023	Concrete update			
Rev.	Date	Description	Drawn by	Checked by	Approved by
			Drawn by (rev. 0)		
			Checked by (rev. 0)		
			Approved by (rev. 0)		
<b>HOST</b> BIO-ENERGY INSTALLATIONS					Unless otherwise specified all dimensions are in mm
Title: Plotplan CO2 liquefaction					
Drawing no. H4944-tek02-01		Rev. 08	Plot date 6-12-2023	Date rev. 0 (original) 09-06-2022	Projection
Project no. H4944	Client Wabico CO2 liquefaction	Scale 1:50	Size A1	Sheet 1 of 1	