


STARBOARD VIEW

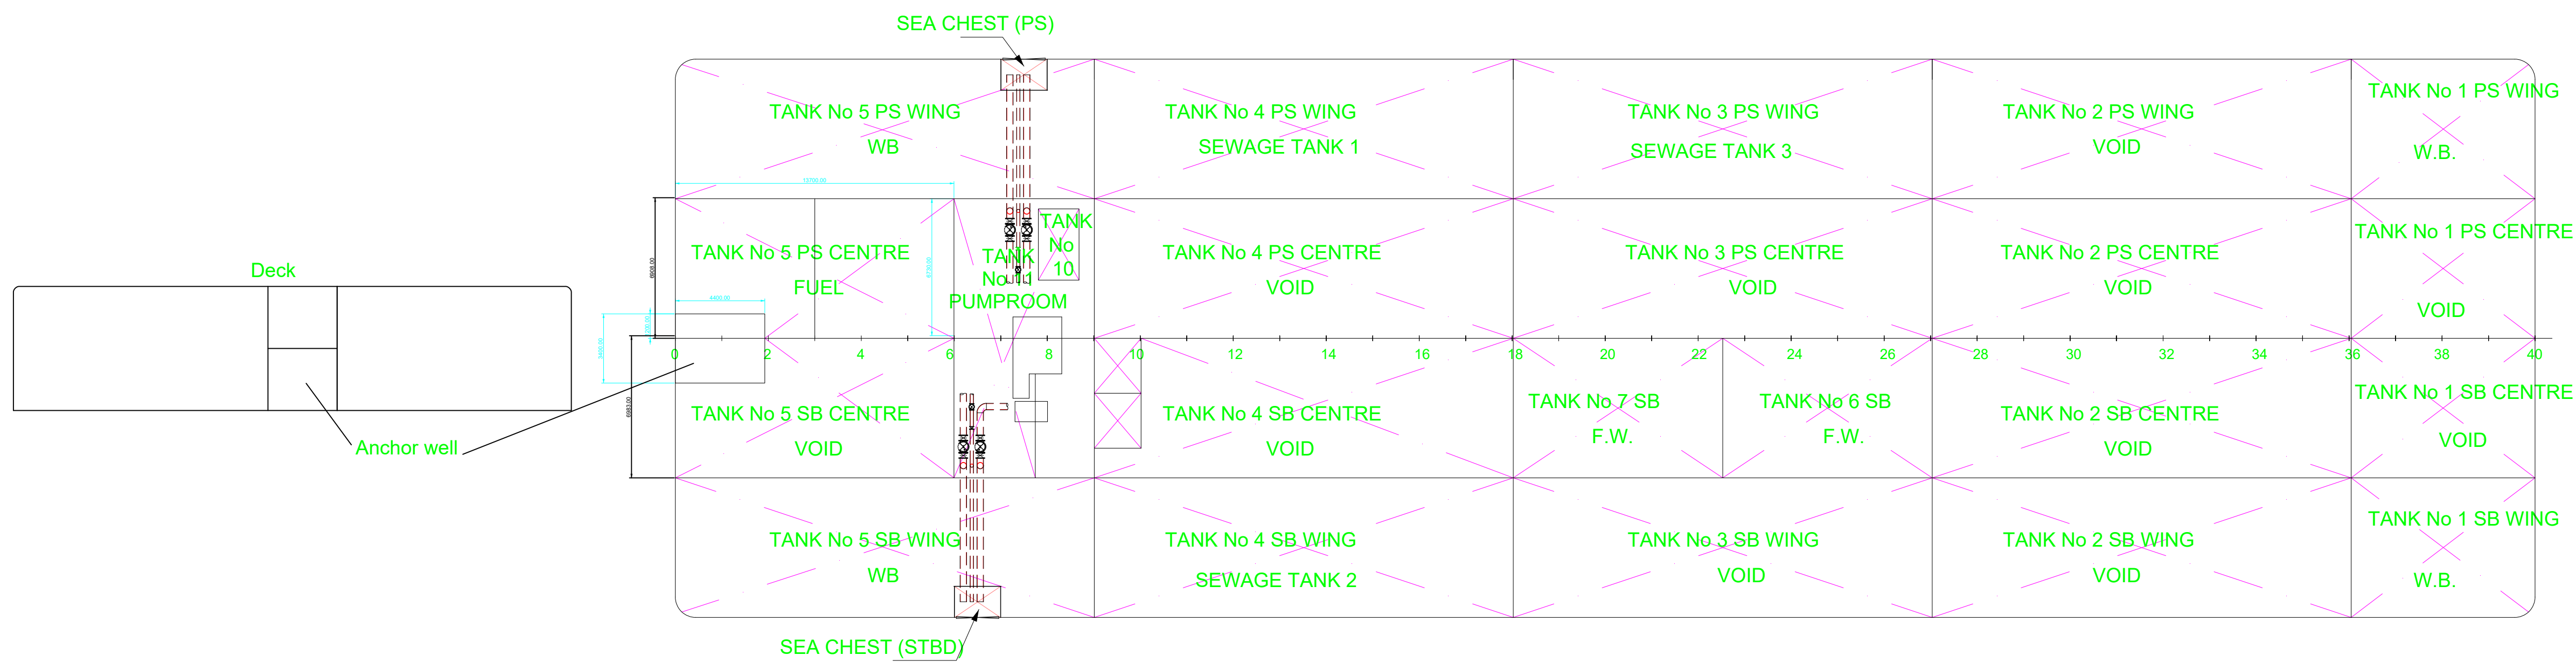

BARGE SECTION

VOID SPACES	FR - FR	CAPACITY (M ³)
TANK No 1 SB CENTRE	36 - 40	238
TANK No 1 PS CENTRE	36 - 40	238
TANK No 2 SB WING	27 - 36	852
TANK No 2 PS WING	27 - 36	852
TANK No 2 SB CENTRE	27 - 36	854
TANK No 2 PS CENTRE	27 - 36	854
TANK No 3 SB WING	18 - 27	852
TANK No 3 PS CENTRE	18 - 27	854
TANK No 4 SB CENTRE	9 - 18	854
TANK No 4 PS CENTRE	9 - 18	854
TANK No 5 SB CENTRE	0 - 6	538

BALLAST WATER	FR - FR	CAPACITY (M ³)
TANK No 1 SB WING	36 - 40	238
TANK No 1 PS WING	36 - 40	238
TANK No 5 SB WING	0 - 9	854
TANK No 5 PS WING	0 - 9	854

SEWAGE	FR - FR	CAPACITY (M ³)
TANK No 4 PS WING	9 - 18	852
TANK No 4 NO LONGER USED	9 - 10	10
TANK No 3 NO LONGER USED	9 - 10	10
TANK No 3 PS WING	18 - 27	852
TANK No 4 SB WING	9 - 18	852

FRESH WATER	FR - FR	CAPACITY (M ³)
TANK No 6	22 - 27	310
TANK No 7	18 - 22	240

FUEL	FR - FR	CAPACITY (M ³)
TANK No 5 PS CENTRE	0 - 6	550
TANK No 12	1 - 2	14
TANK No 13	1 - 2	2.4
SHORE GENERATOR	0 - 3	6

OILY BILGE WATER	FR - FR	CAPACITY (M ³)
TANK No 10	8 - 9	10

COOLING WATER	FR - FR	CAPACITY (M ³)
TANK No 11	6 - 9	129

MAIN DIMENSIONS

LENGTH BETWEEN P.P.	-	300' (91.440M)
BREADTH MLD	-	90' (27.432M)
DEPTH	-	20' (6.096M)
OPERATION DRAUGHT	-	abt. 7.5' (2.3M)
AIR DRAUGHT	-	abt. 69' (20.3M)
NUMBER OF 2 PERSON PASSENGER CABINS	-	55
NUMBER OF CREW CABINS	-	6

CLASS : LLOYDS REGISTER + IAI/RE FLOATING HOTEL

REV	DATE	DESCRIPTION	DRNCHKAPP
1	13/06/2023	Updated mooring equipment	BML
0	10/05/2023	AS BUILT	BM/KR KR

CAD PRODUCED DRAWING
NOT TO BE CHANGED MANUALLY

DWG. TITLE
**BIBBY PROGRESS
GENERAL ARRANGEMENT
SHEET 1 OF 3**

DWG. NO PRO-GA-100.1	REV. 1	SCALE 1:200
-------------------------	-----------	----------------