


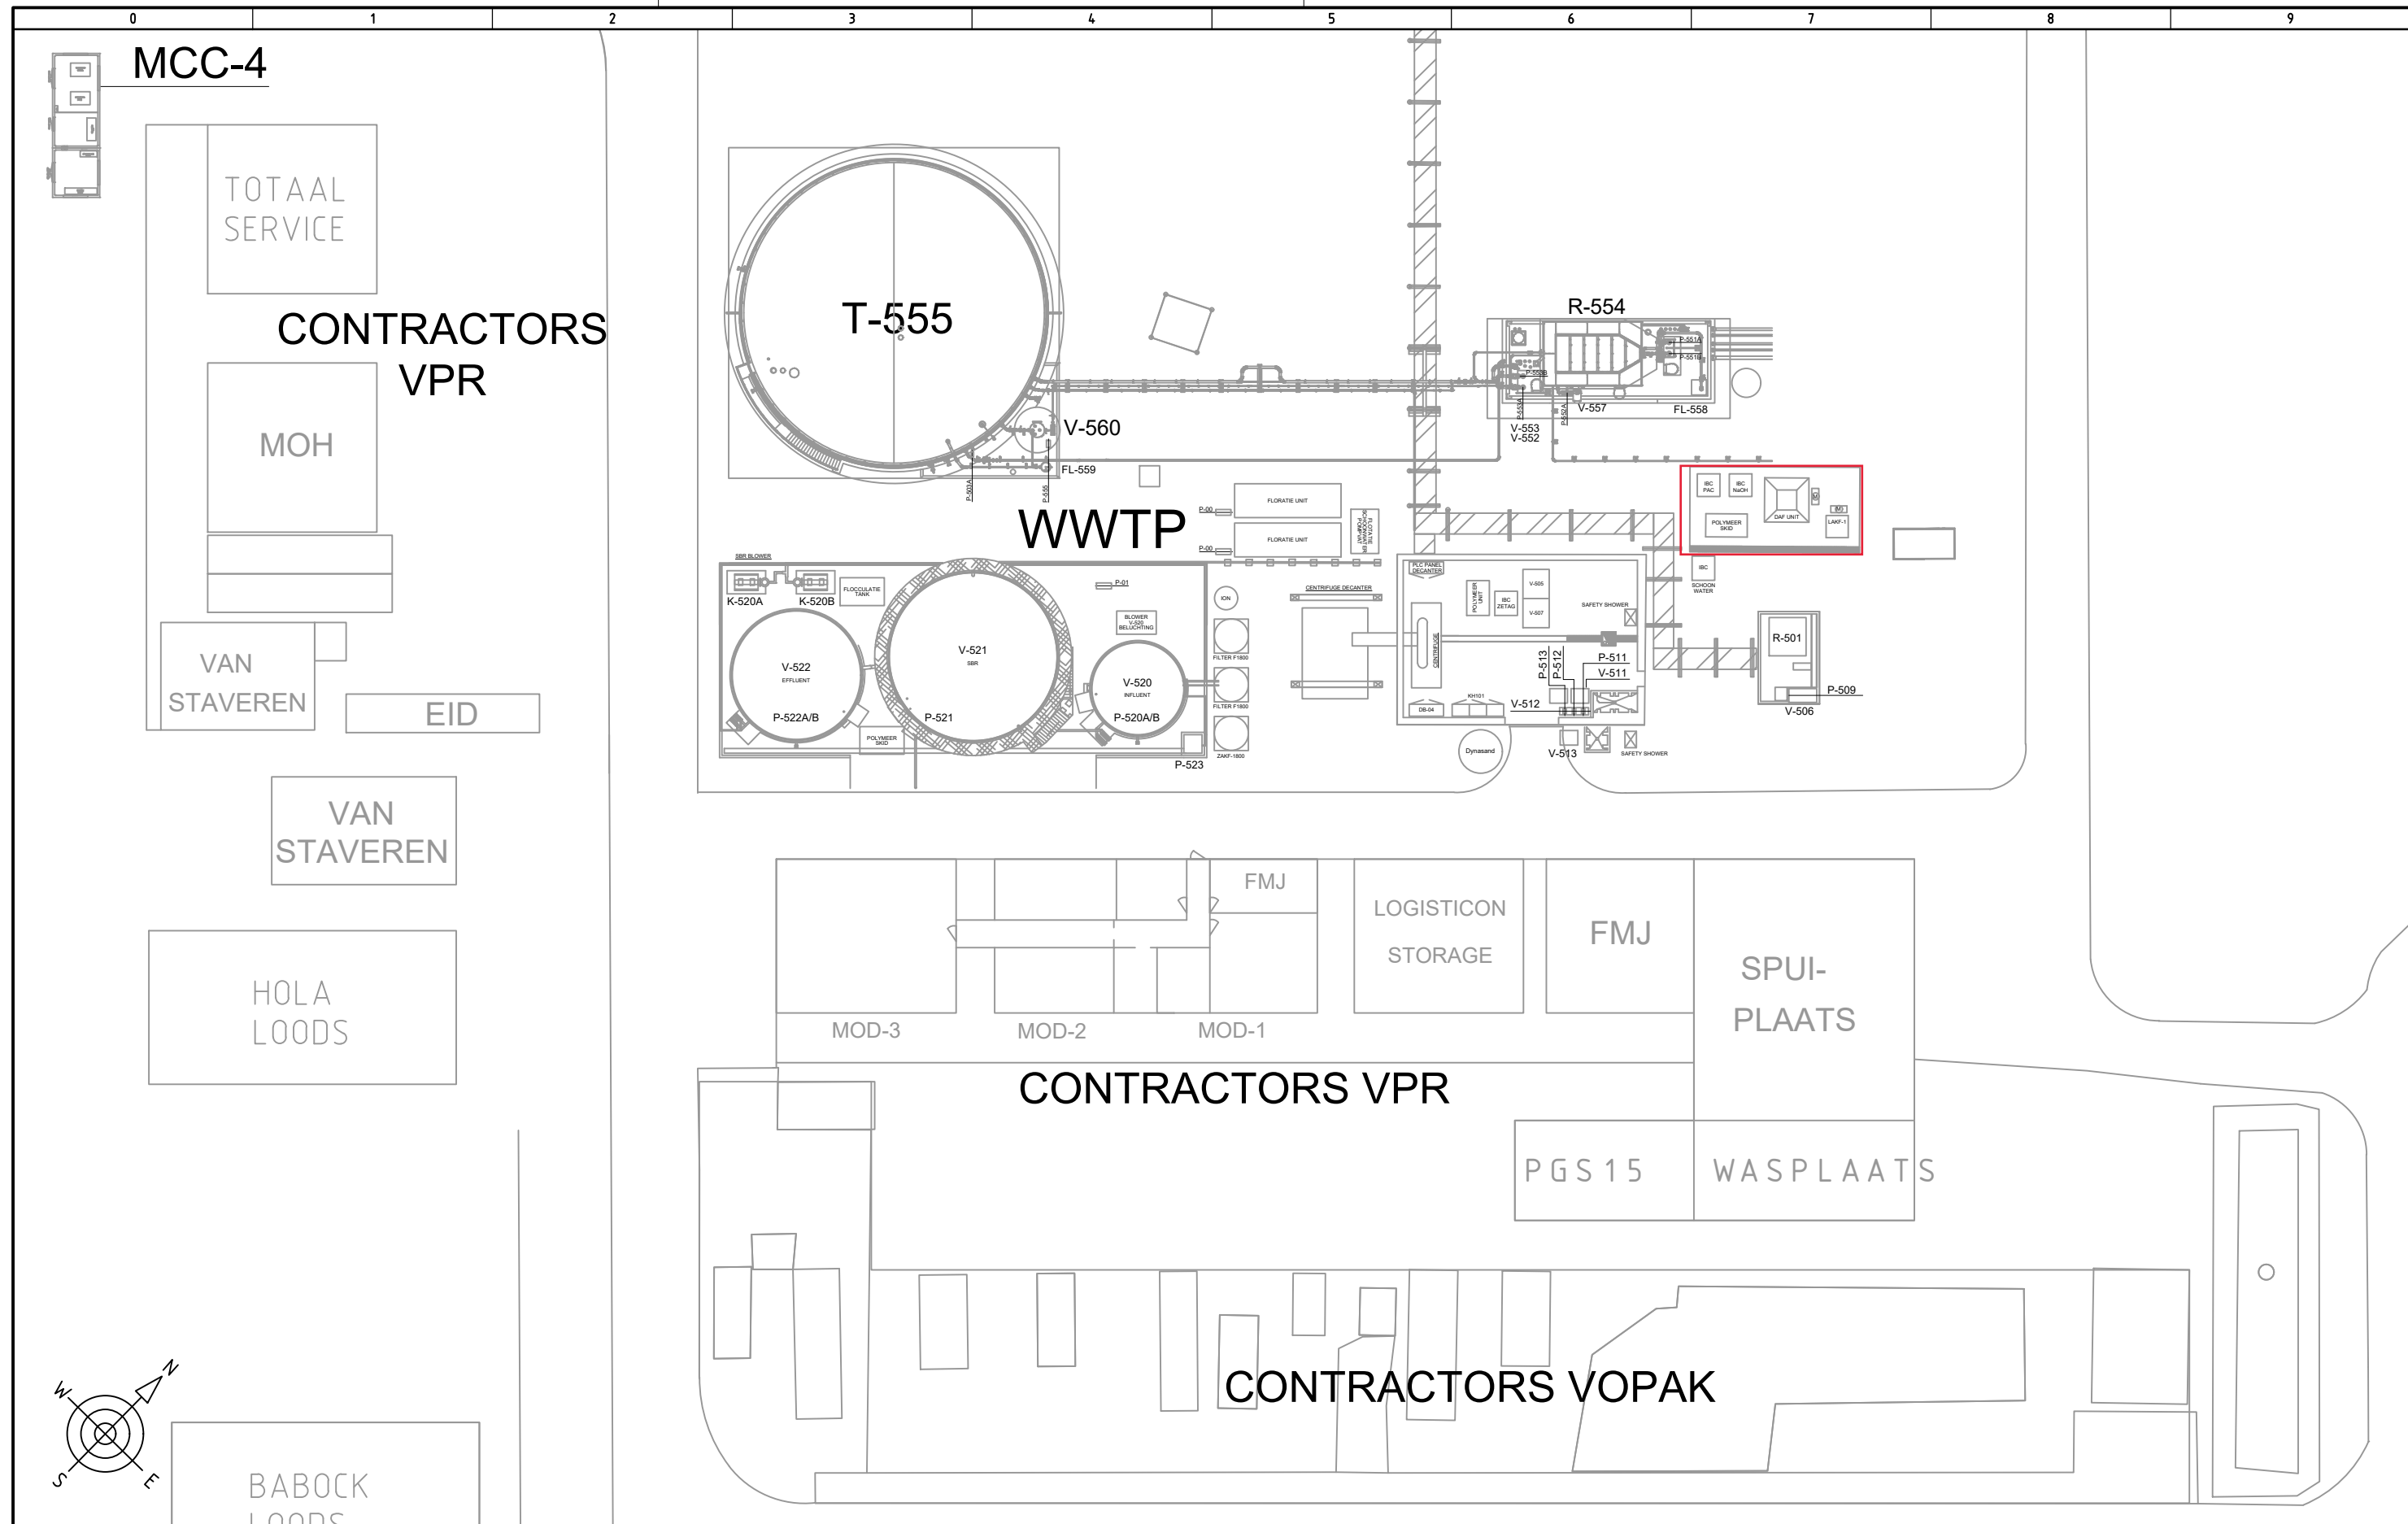

Rev.	Description	Drawn by	Date	Checked by	 FMJ ELEKTRO B.V.		VPR ENERGY B.V.			
0	As Built for Project no. 04380	JM	19-09-2008	BBO			SITEPLAN LAYOUT			
1	Revised	MSS	22-10-2015	PvL			-			
2	New F-102 construction and MCC-1 layout	MM	18-10-2019	AT			WWTP + CONTRACTORS AREA			
3	WWTP DECANTER + LOGISTICON UPDATE	MM	23-09-2020	AT			Dwg No	ROT-E&I-LAY-SP	Sheet 8 of 8	Size A3
					Date Created: 23-09-2020	Date Approved: 23-09-2020				
					Drawn by: MM	Approved by: AT				
					Checked by: AT	Scale: 1:400				