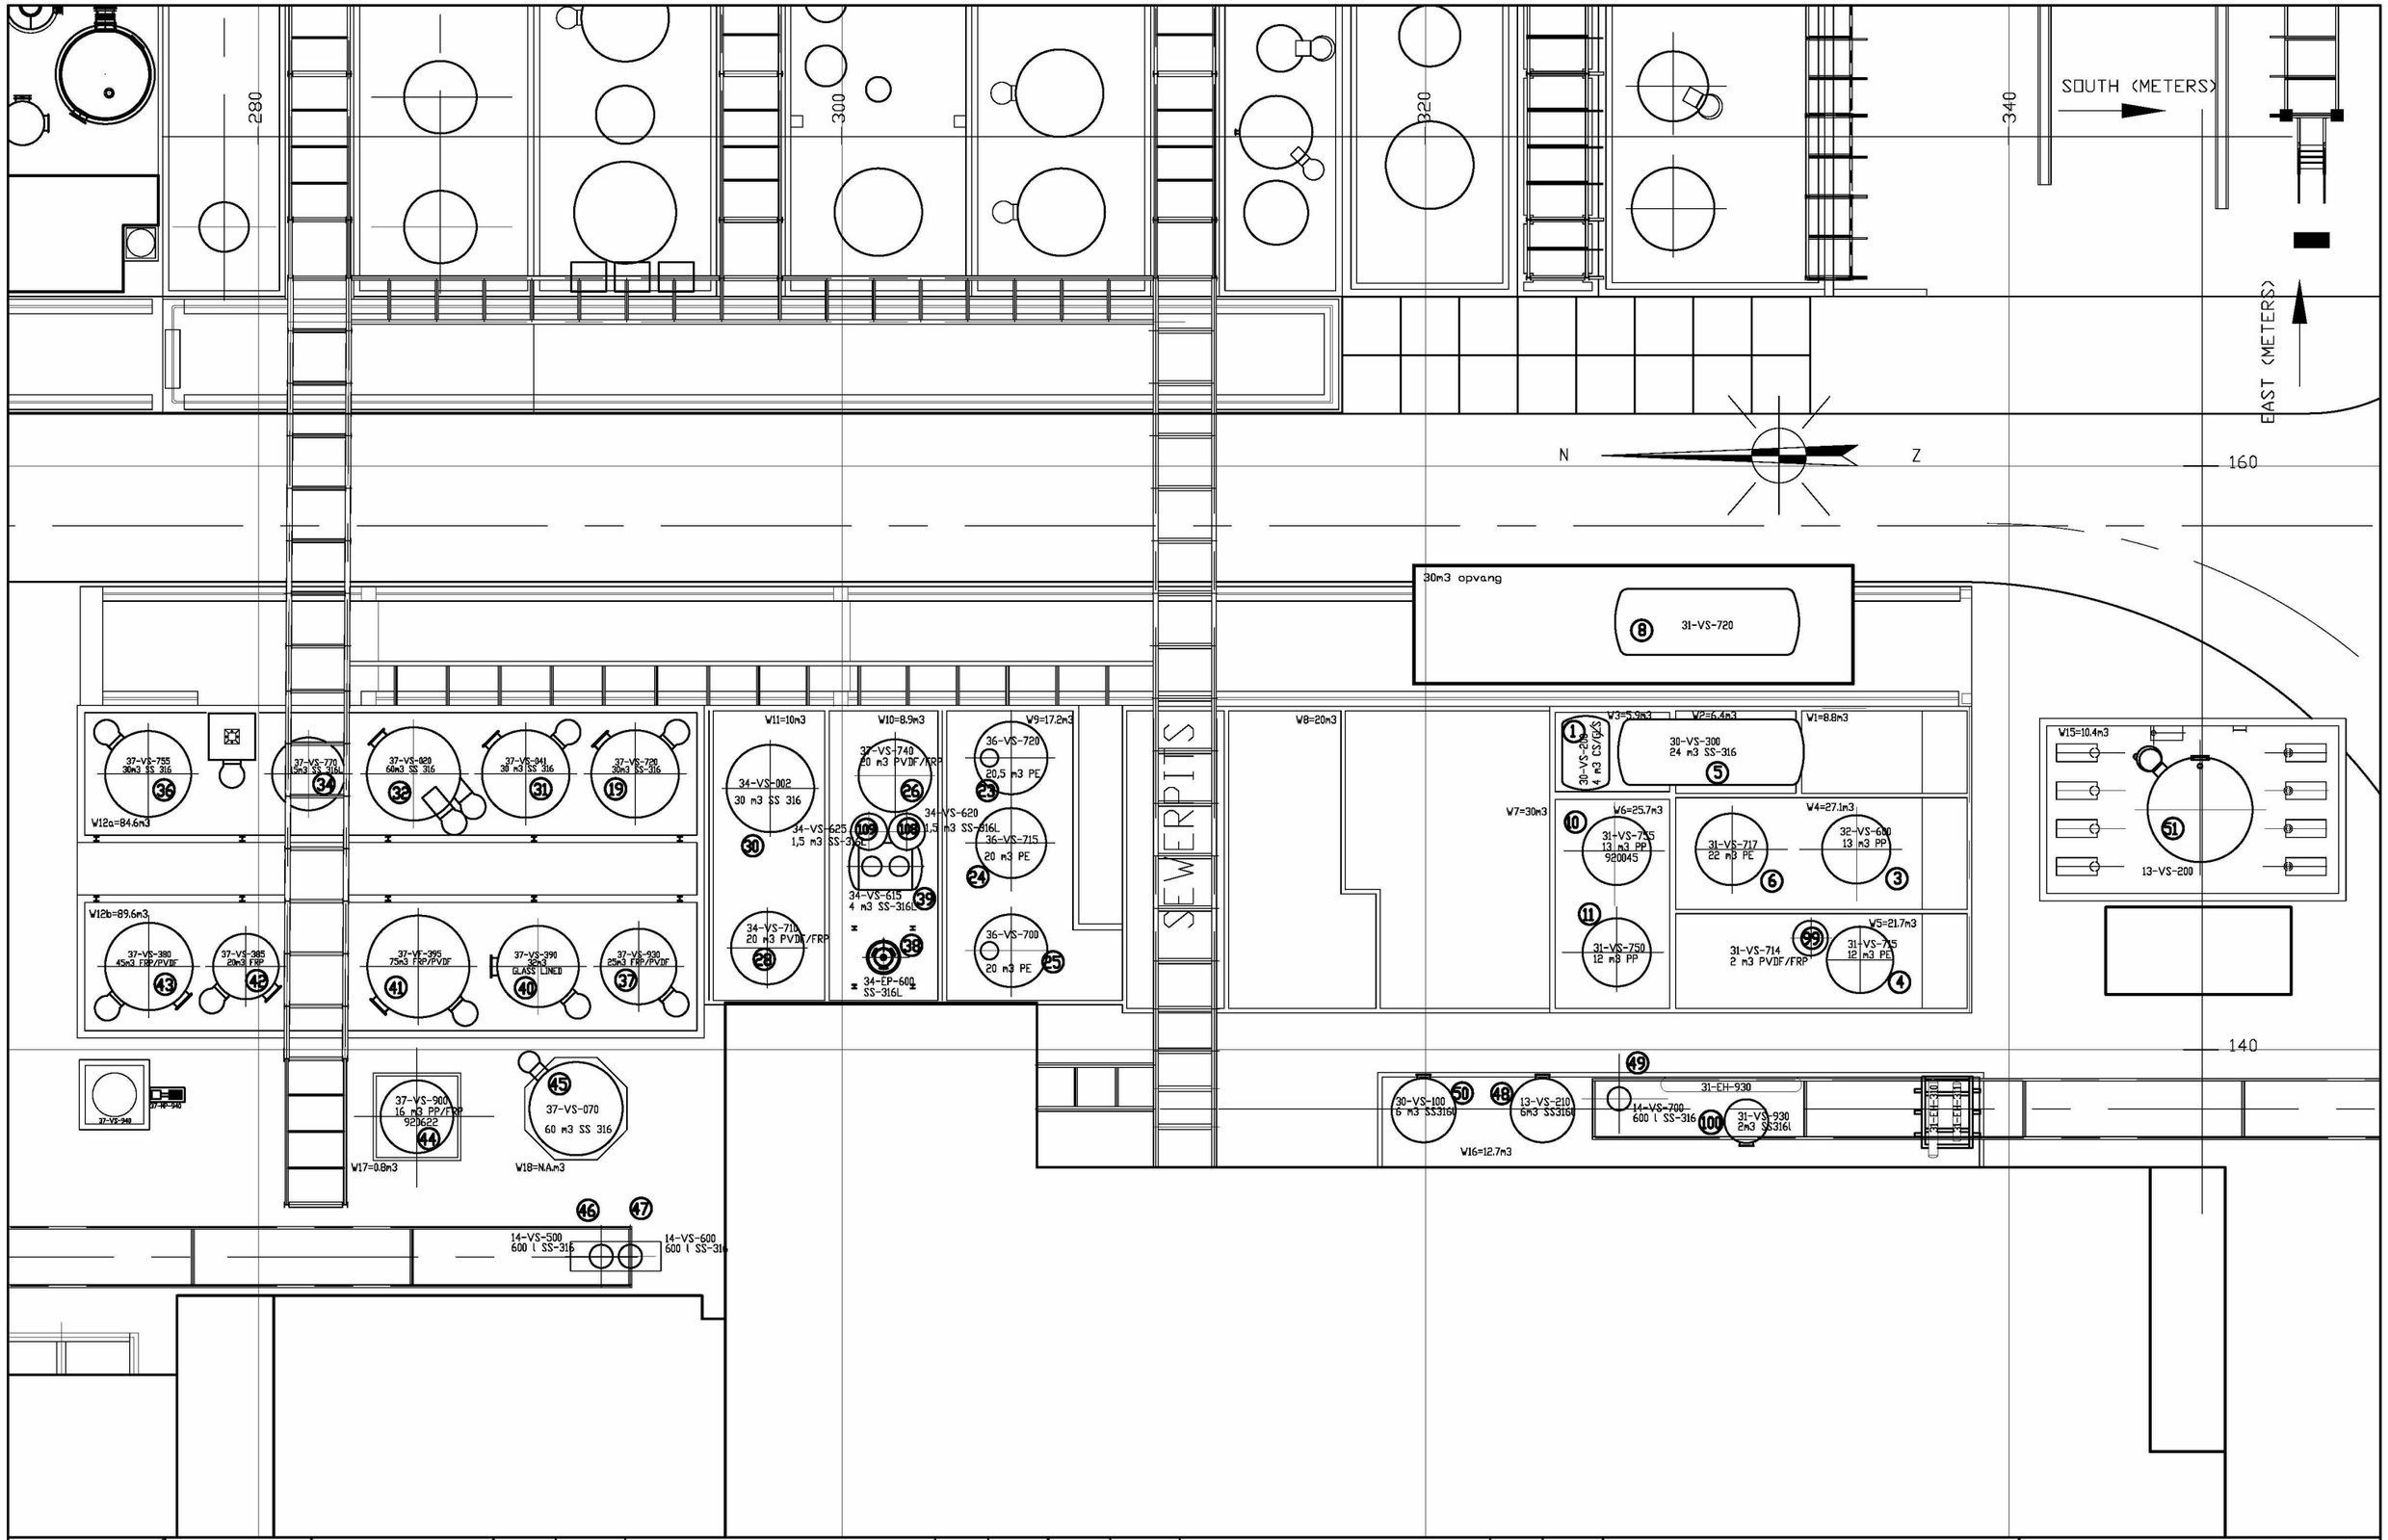

STATUS INSTALLATION	STATUS DRAWING	ENG. :	REV.	DATE	DESCRIPTION	DRAWN	CHECKED	REV.	DATE	DESCRIPTION	DRAWN	CHECKED
		SCALE : 1:200	22	30-01-20	Calculate volume of W15	I.S.						
			21	17-10-19	31-VS-720 installed on temporary location	E.B.						
Not existing ○	For engineering ○	DRAWN 2E	20	29-07-2019	Remove glycol tank	IbSh	M.G					
Under construction ○	For construction ○	CHKD. :	19	17-07-19	Number correction. 37-VS-755 on 36	IbSh	M.G	23	05-03-20	Updated the Netto Volume	I.S.	
Operative ○	As built ●	DATE : 28-09-00										

TITLE: Lay-out

GBC tankfarm

DWG Nr.: 03-06-06-0020-001 **REV. Nr.:** 23

ICL Industrial Products