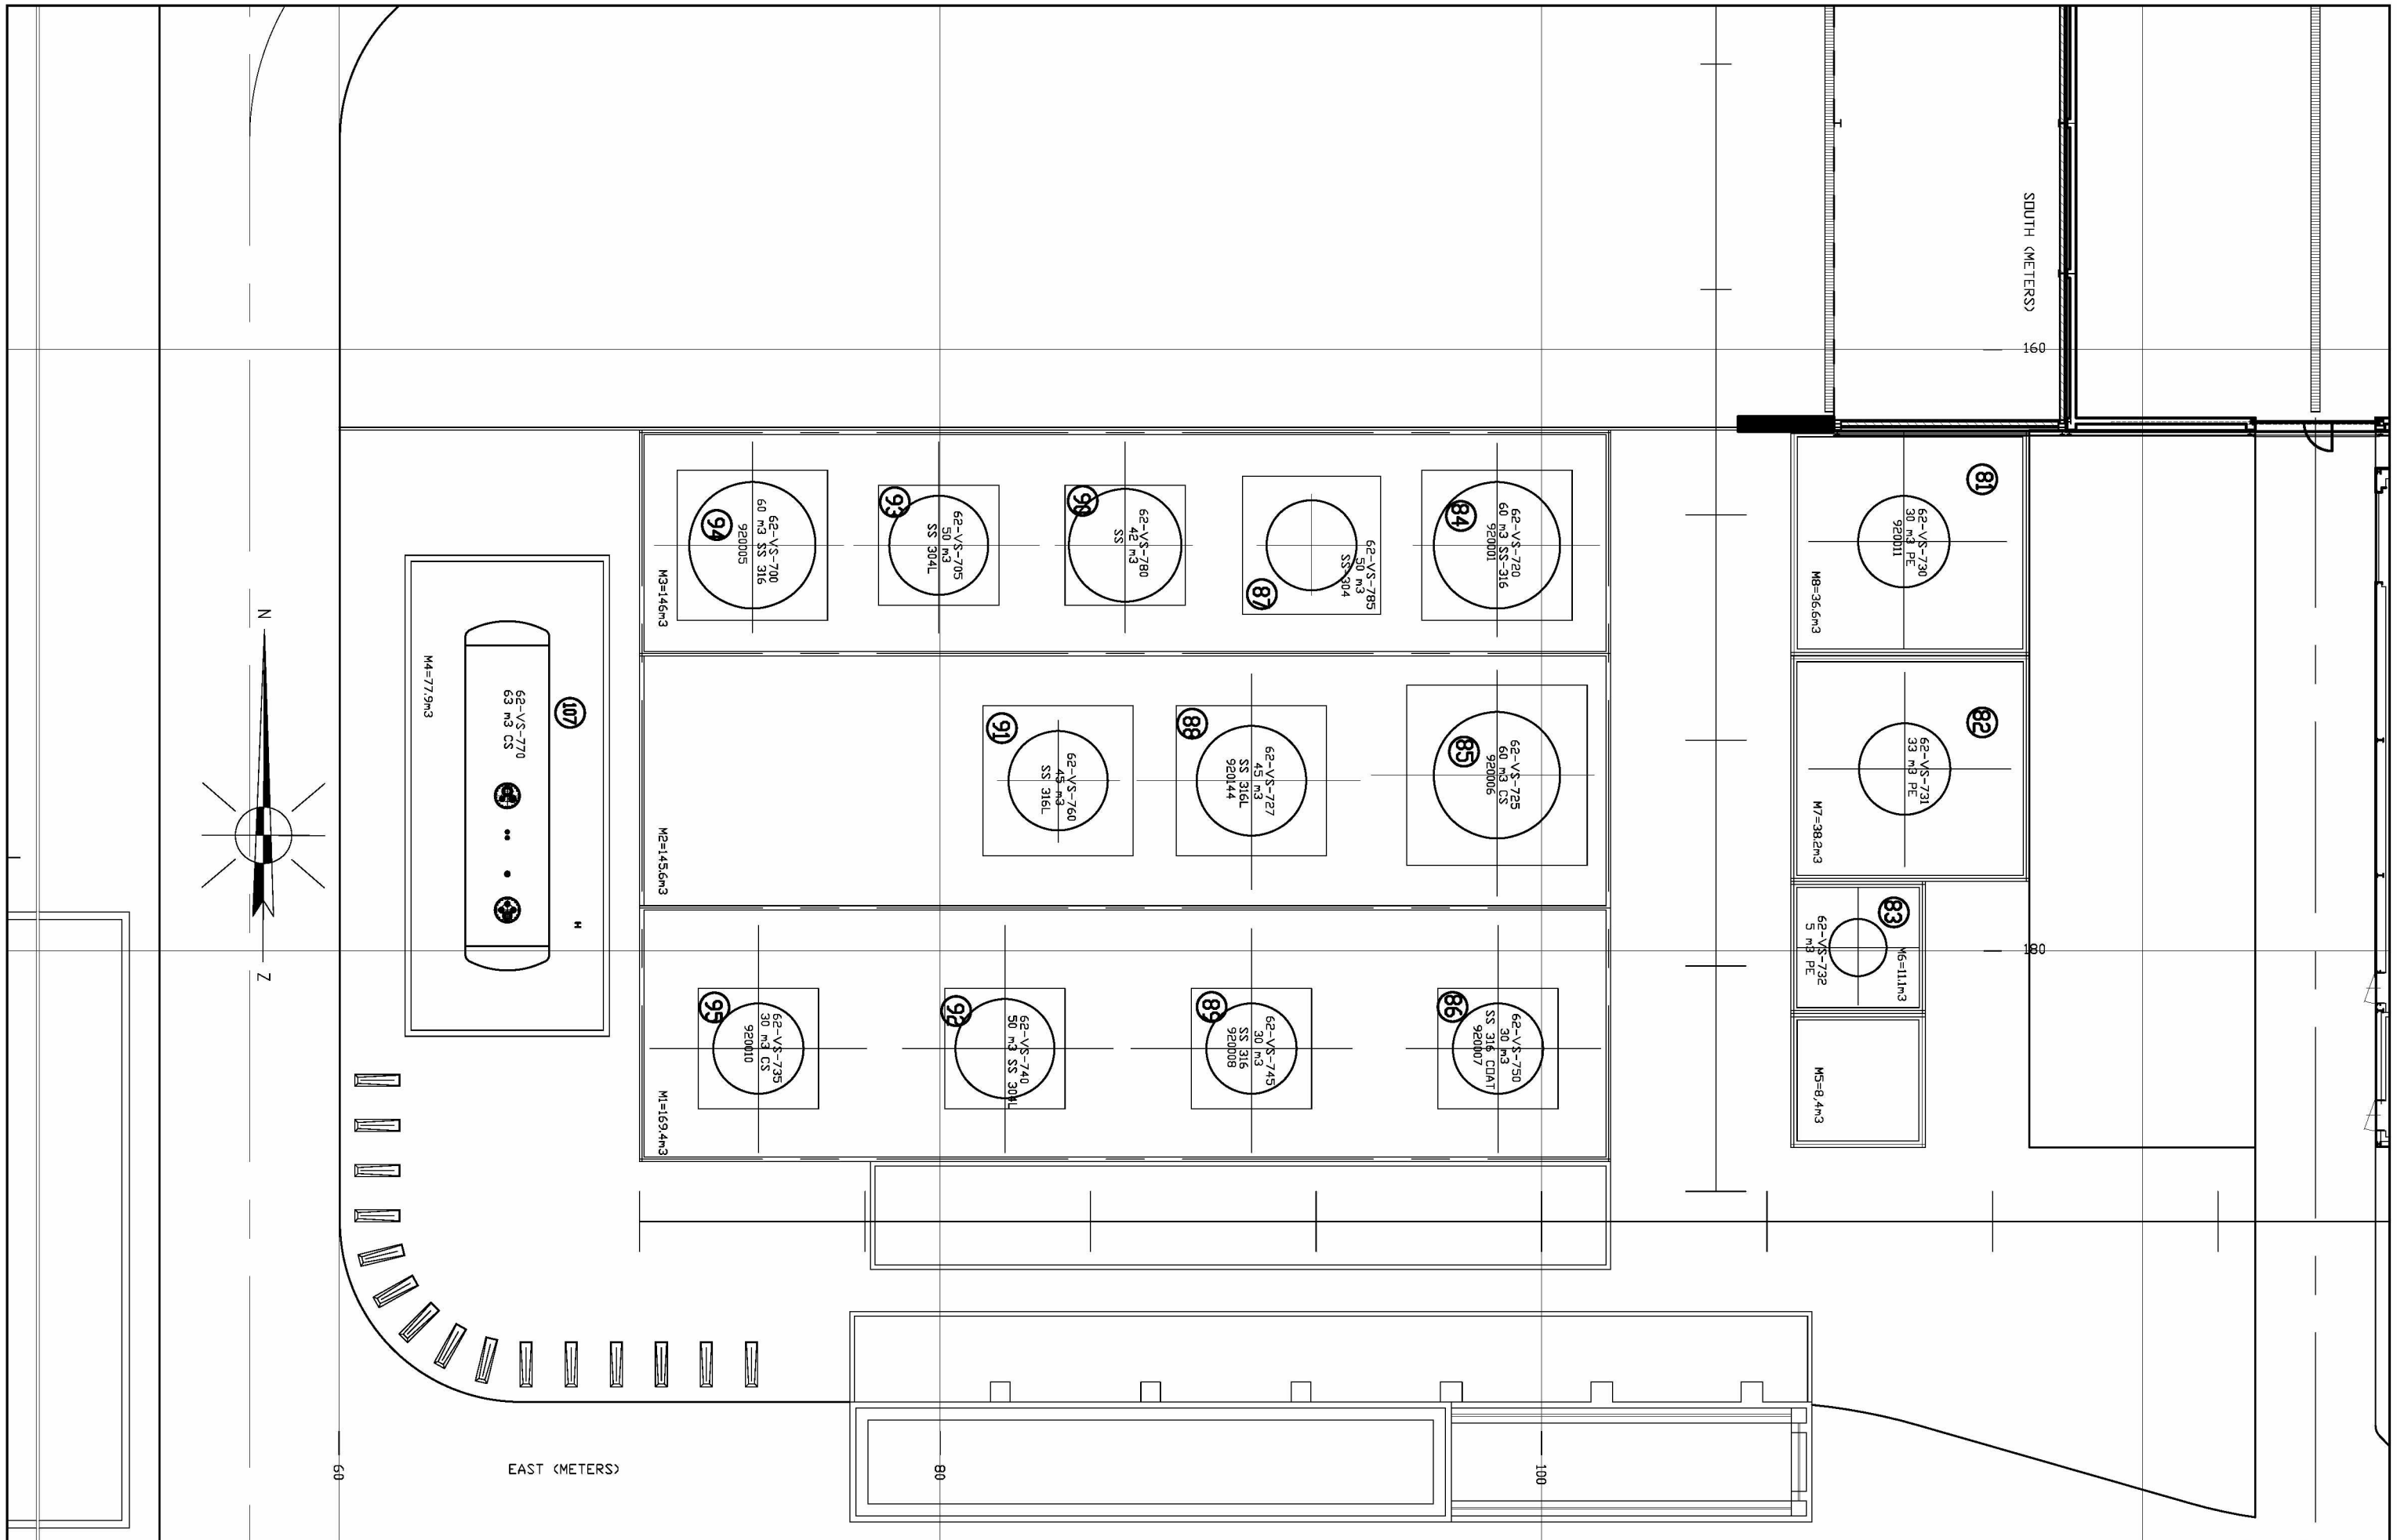

STATUS INSTALLATION	STATUS DRAWING	ENG. :	04	18-09-08	Tankbassins defined	E.B.							
		SCALE : 1:200	03	09-05-07	62-VS780 & 785 installed	E.B.							
Not existing ○	For engineering ○	DRAWN :	02	30-01-06	New tank 62-VS-770 + bassin	E.B.		06	05-03-20	Updated the Netto Volume	J.S.		
Under construction ○	For construction ○	CHKD. :	01	28-09-00	New tanks 62-VS-715 & 760	E.B.		05	4-10-12	Update	E.B.		
Operative ○	As built ●	DATE : 02-12-94	REV.	DATE	DESCRIPTION	DRAWN	CHECKED	REV.	DATE	DESCRIPTION	DRAWN	CHECKED	

TITLE: Storage
Lay-out
Main tankfarm

DWG Nr.: 03-06-06-0020-003 **REV. Nr.:** 06

ICL Industrial Products