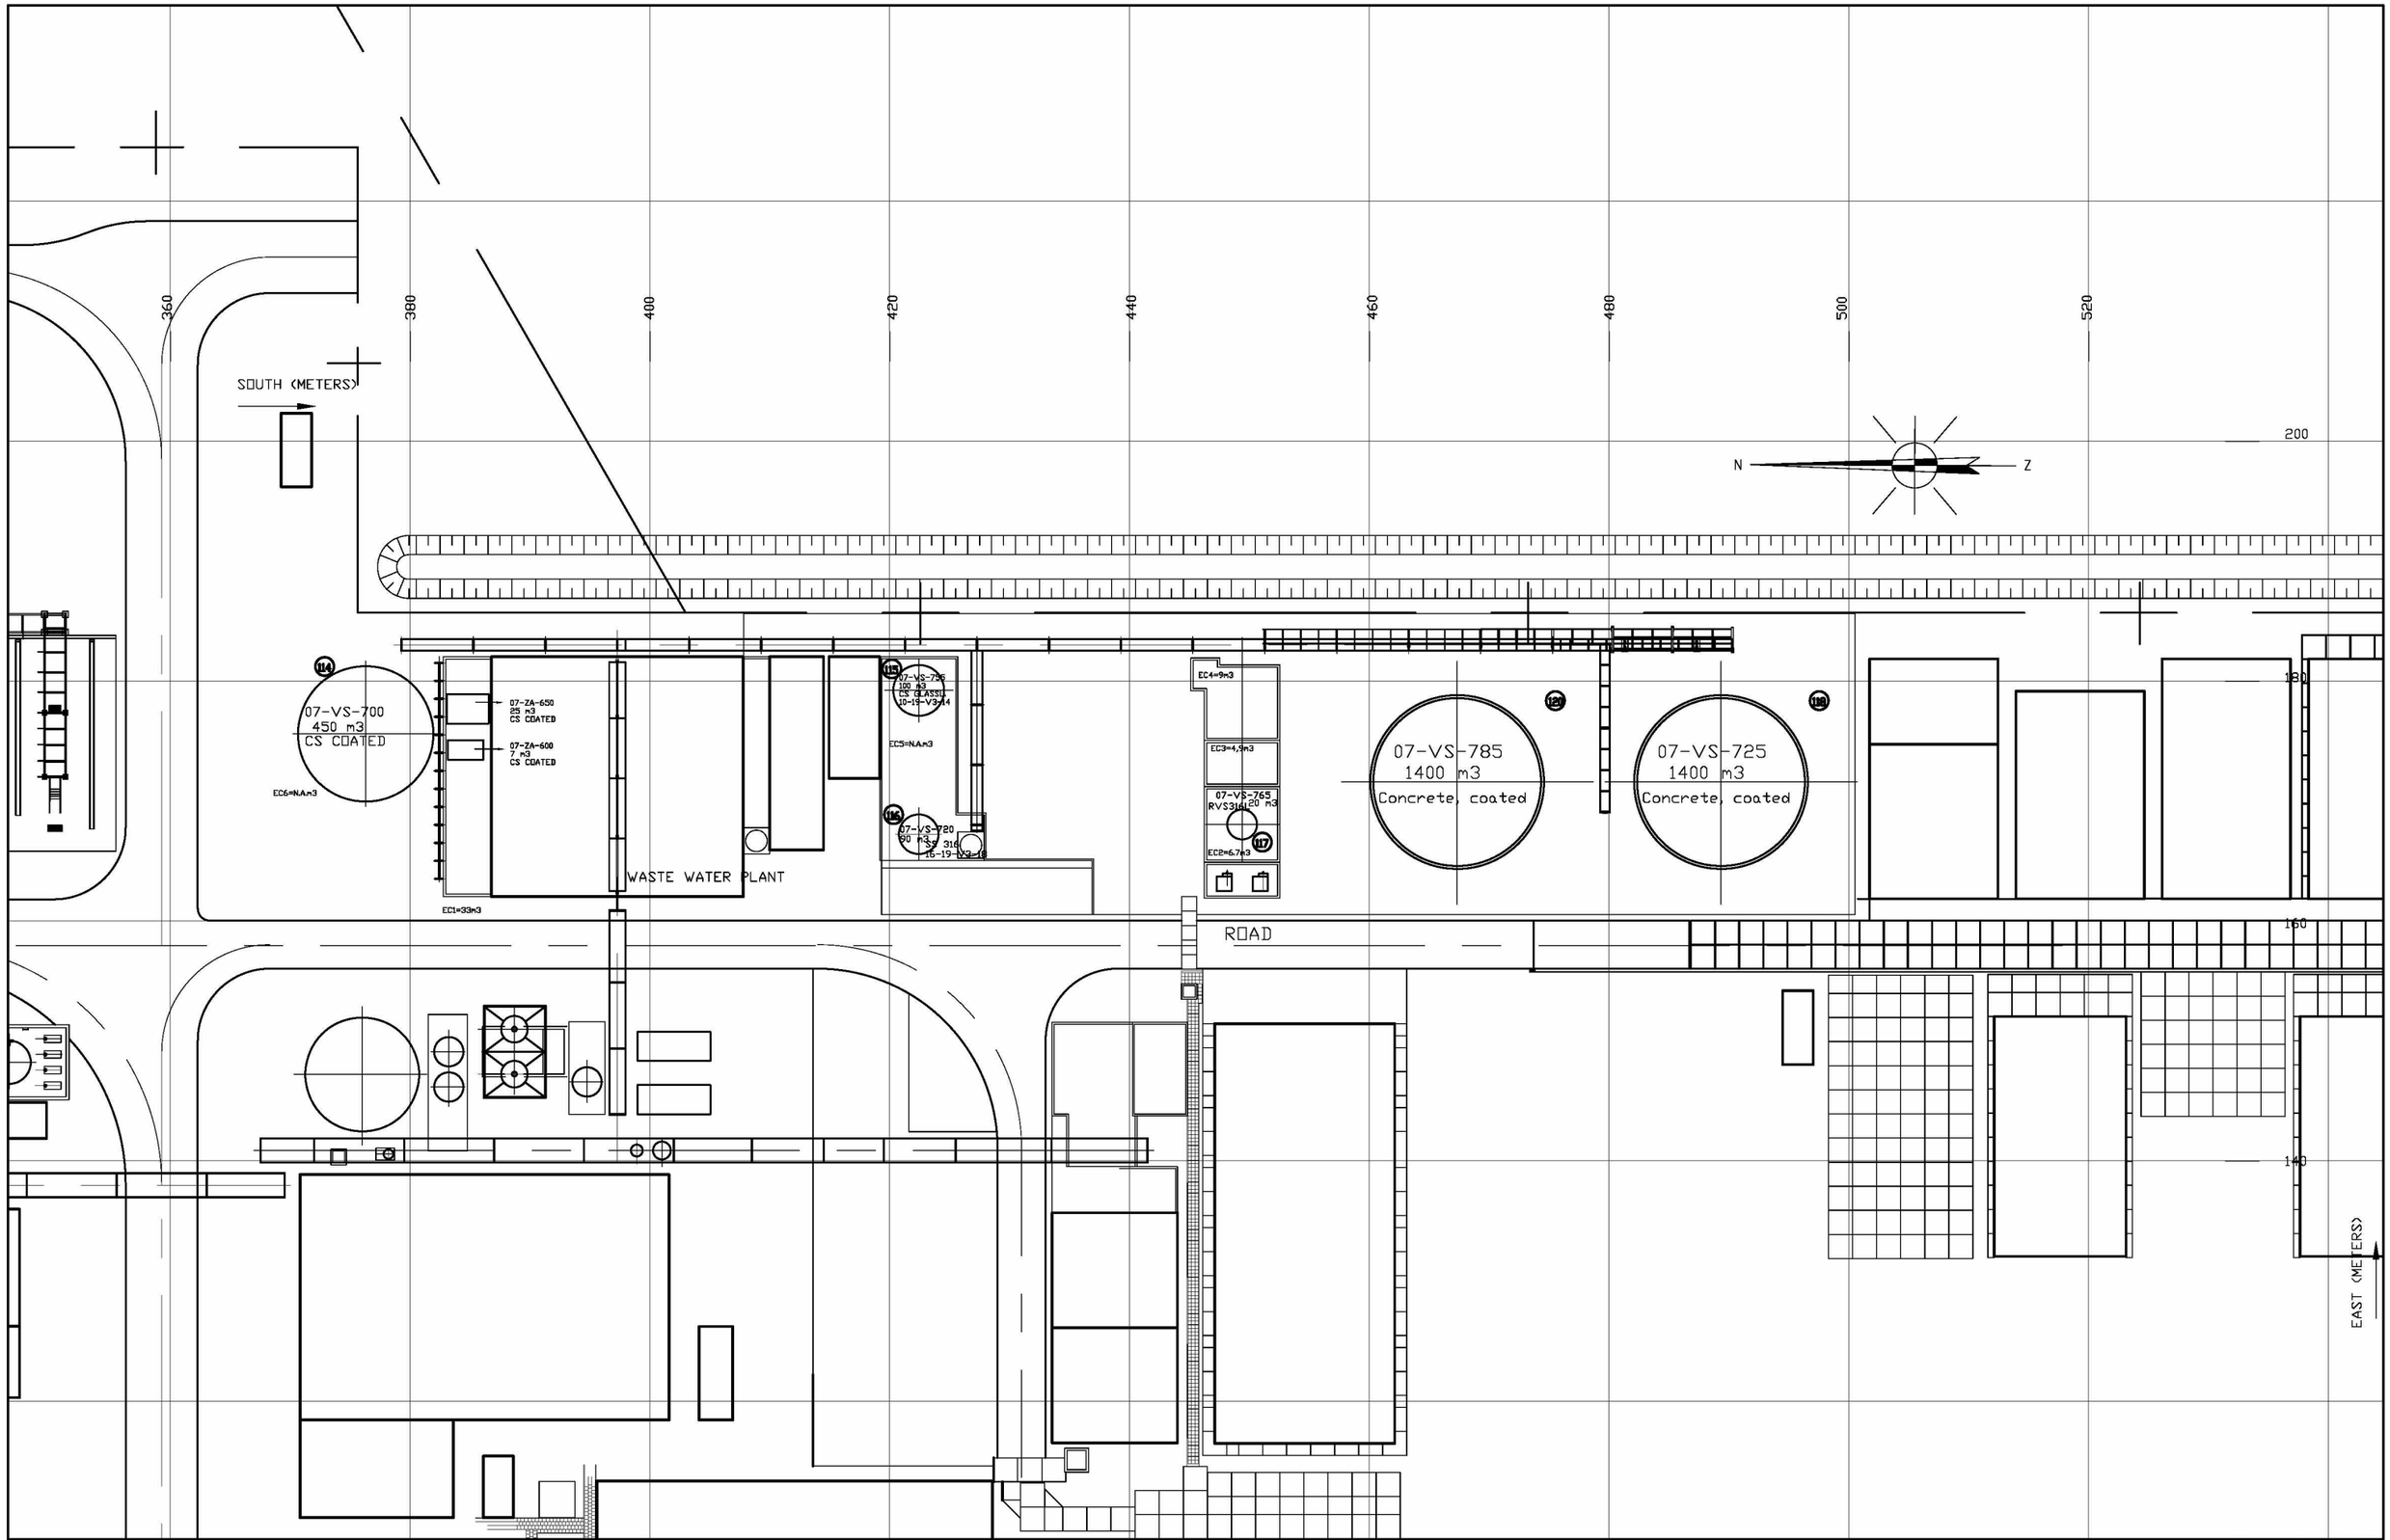

STATUS INSTALLATION	STATUS DRAWING	ENG. :	REV.	DATE	DESCRIPTION	DRAWN	CHECKED	REV.	DATE	DESCRIPTION	DRAWN	CHECKED
		SCALE : 1:500	09	30-01-20	Update volume of EC5	I.S.						
Not existing ○	For engineering ○	DRAWN :	08	22-01-20	Remove tanks 07-VS-770/756	I.S.						
Under construction ○	For construction ○	CHKD. :	07	28-09-18	Situation dd 28-09-18	E.B.						
Operative ○	As built ●	DATE : 08-12-94	06	09-06-17	Ecologie tanks updated	E.B.		10	05-03-20	Updated the Netto Volume	I.S.	

TITLE: Waste Lay-out Location tanks

DWG Nr.: 03-16-19-0005-000 **REV. Nr.:** 10

ICL Industrial Products