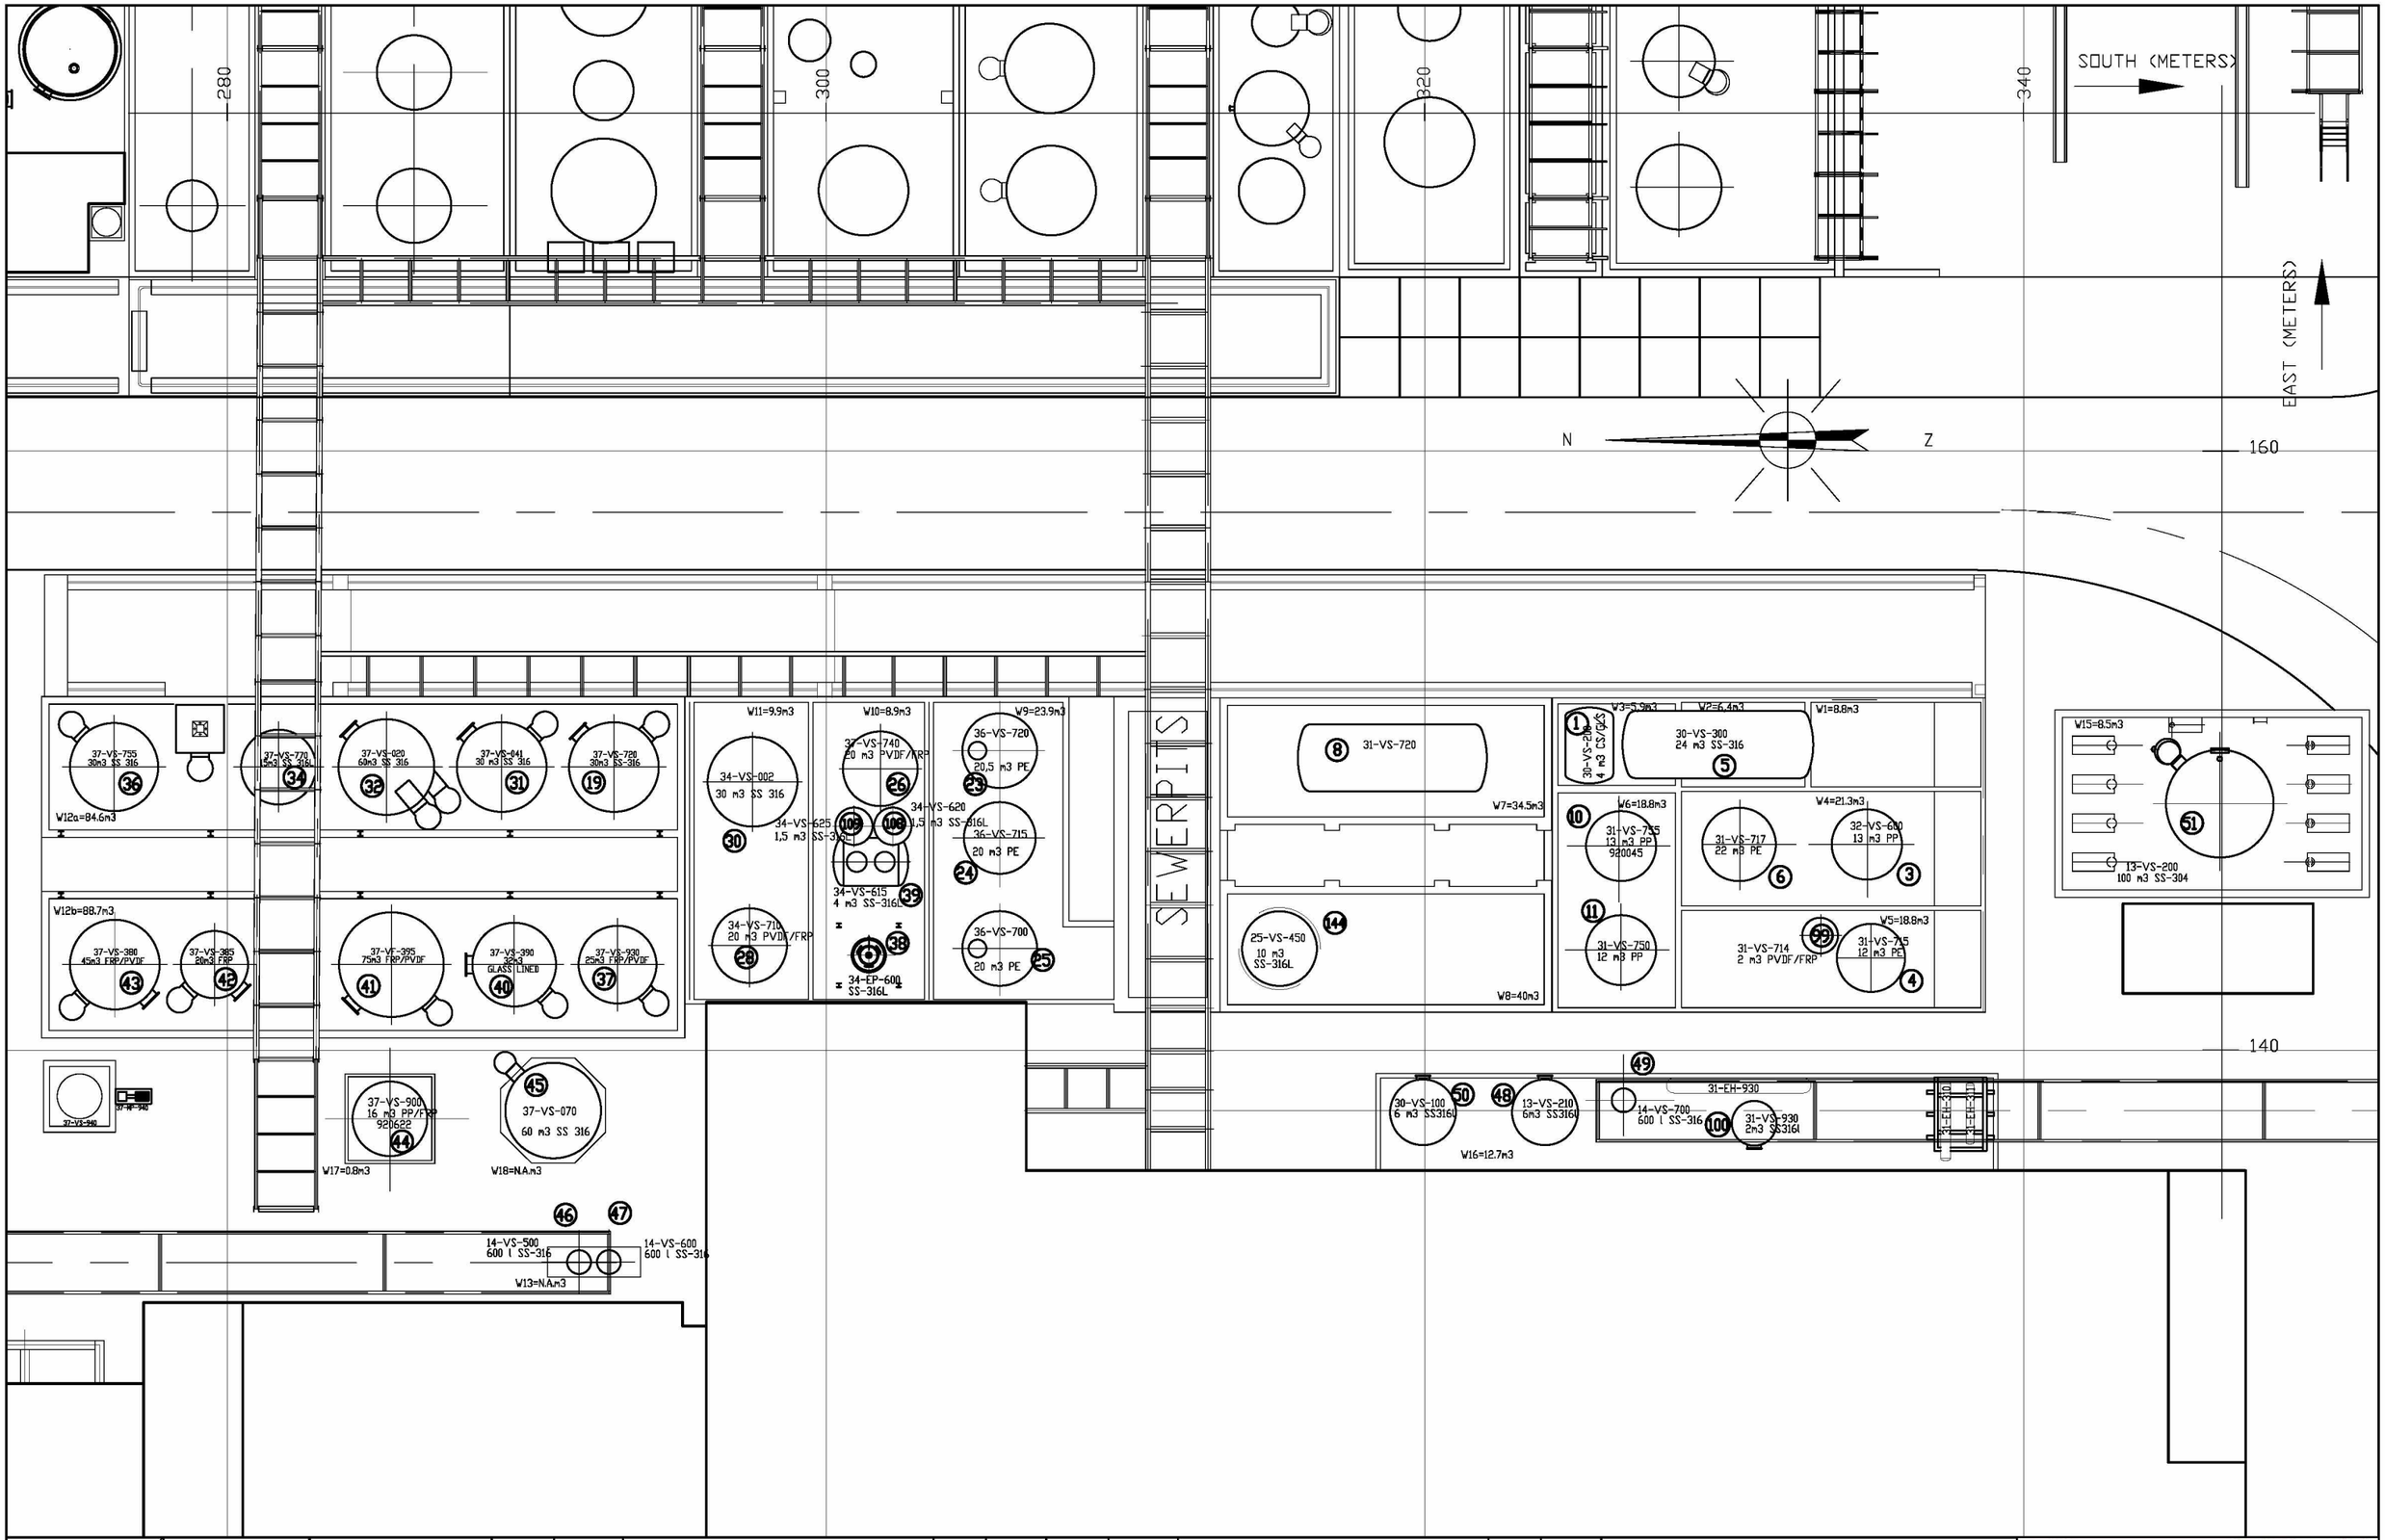

STATUS INSTALLATION	STATUS DRAWING												
		ENG. :	26	04-11-20	Update the tankput number	I.S.							
		SCALE : 1:200	25	23-10-20	Reinstalled 31-VS-720 on new location	I.S.							
Not existing ○	For engineering ○	DRAWN : 2E	24	31-03-20	Updated the Netto Volume	I.S.		28	05-11-20	Update the tankpak volume of 31-VS-720	I.S.		
Under construction ○	For construction ○	CHKD. :	23	05-03-20	Updated the Netto Volume	I.S.		27	05-11-20	Update the tank 13-VS-200	I.S.		
Operative ○	As built ●	DATE : 28-09-00	REV.	DATE	DESCRIPTION	DRAWN	CHECKED	REV.	DATE	DESCRIPTION	DRAWN	CHECKED	

TITLE: Lay-out

GBC tankfarm

DWG Nr.: 03-06-06-0020-001 **REV. Nr.:** 28

ICL Industrial Products