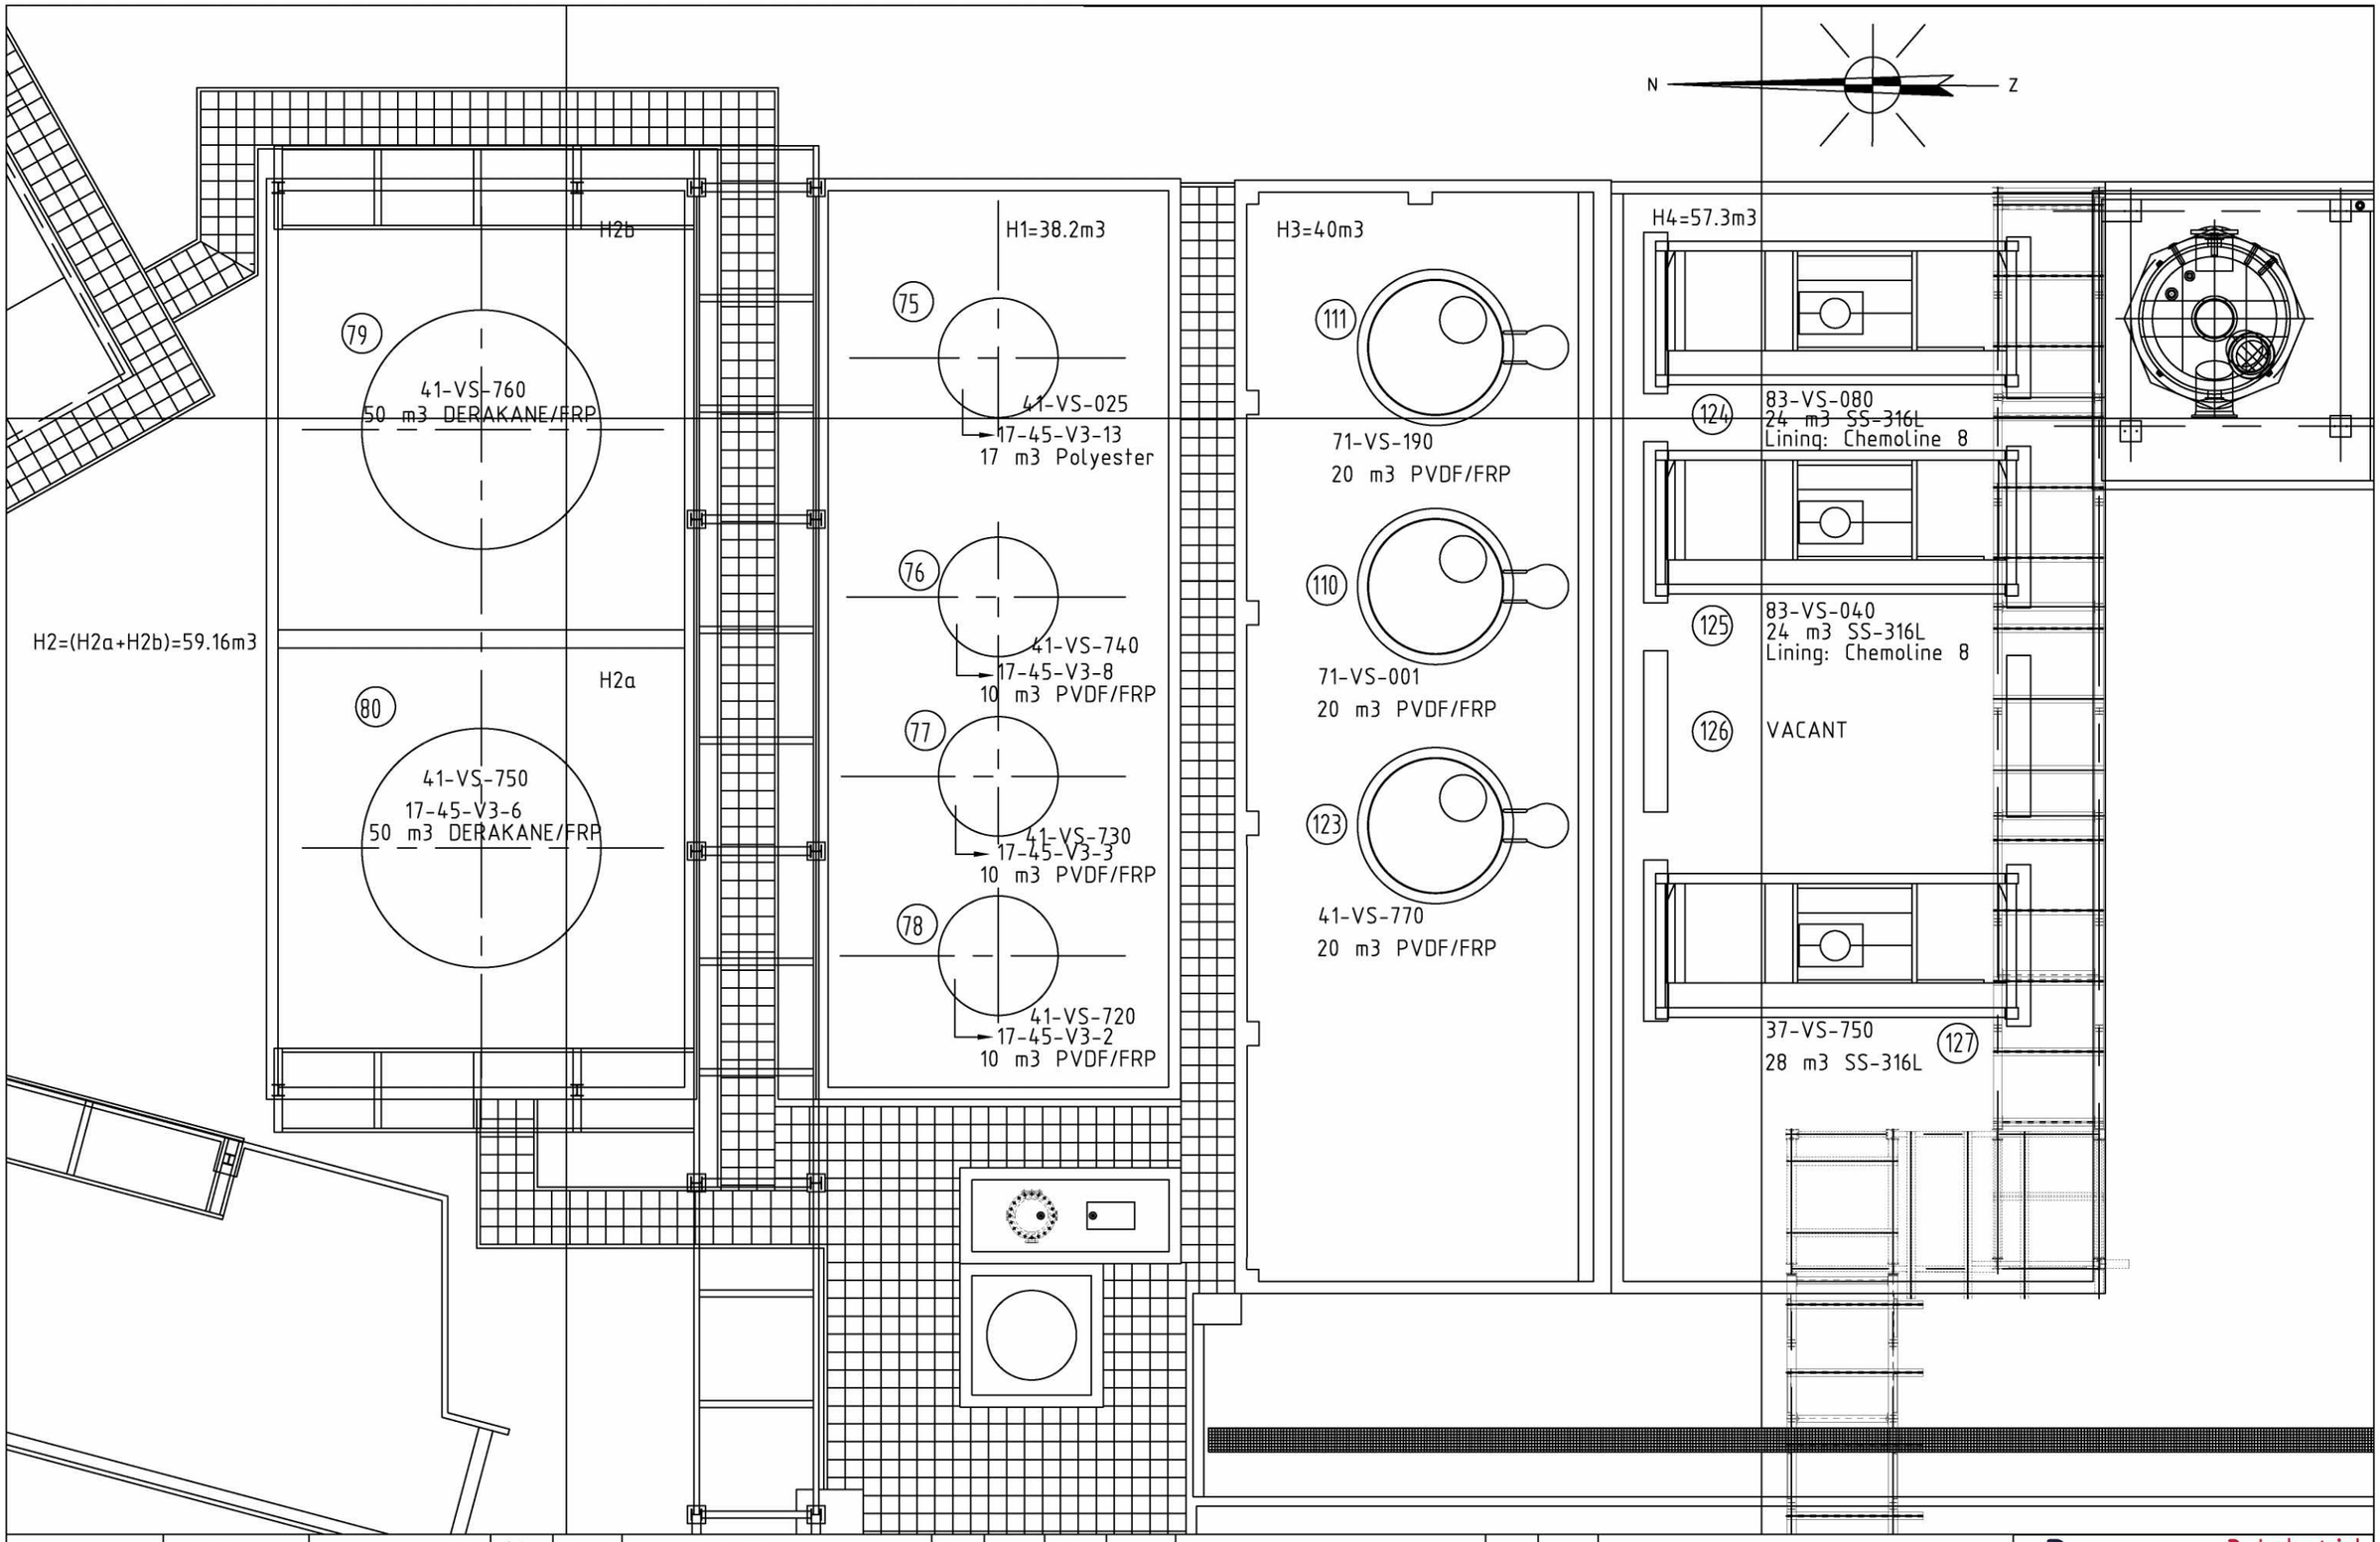

STATUS INSTALLATION	STATUS DRAWING	ENG. :											
		SCALE : 1:100	04	17-04-15	Tank 41-VS-770 installed	E.B.							
Not existing ○	For engineering ○	DRAWN	03	02-03-11	Notation of material of tanks corrected	E.B.		07	31-03-20	Updated the Netto Volume	I.S.		
Under construction ○	For construction ○	CHKD. :	02	03-06-09	Tankbassin for HBr Liquefied installation (H3)	E.B.		06	05-03-20	Updated the Netto Volume	I.S.		
Operative ○	As built ●	DATE : 07-12-94	01	18-09-08	Tankbassins defined	E.B.		05	09-06-17	Tank 83-VS-040/080 and 37- VS-750 installed	JP.T.	E.B.	
			REV.	DATE	DESCRIPTION	DRAWN	CHECKED	REV.	DATE	DESCRIPTION	DRAWN	CHECKED	

TITLE: Storage
Layout
HBr tankfarm
DWG Nr.:03-06-06-0020-004 REV. Nr.: 07

ICL Industrial Products