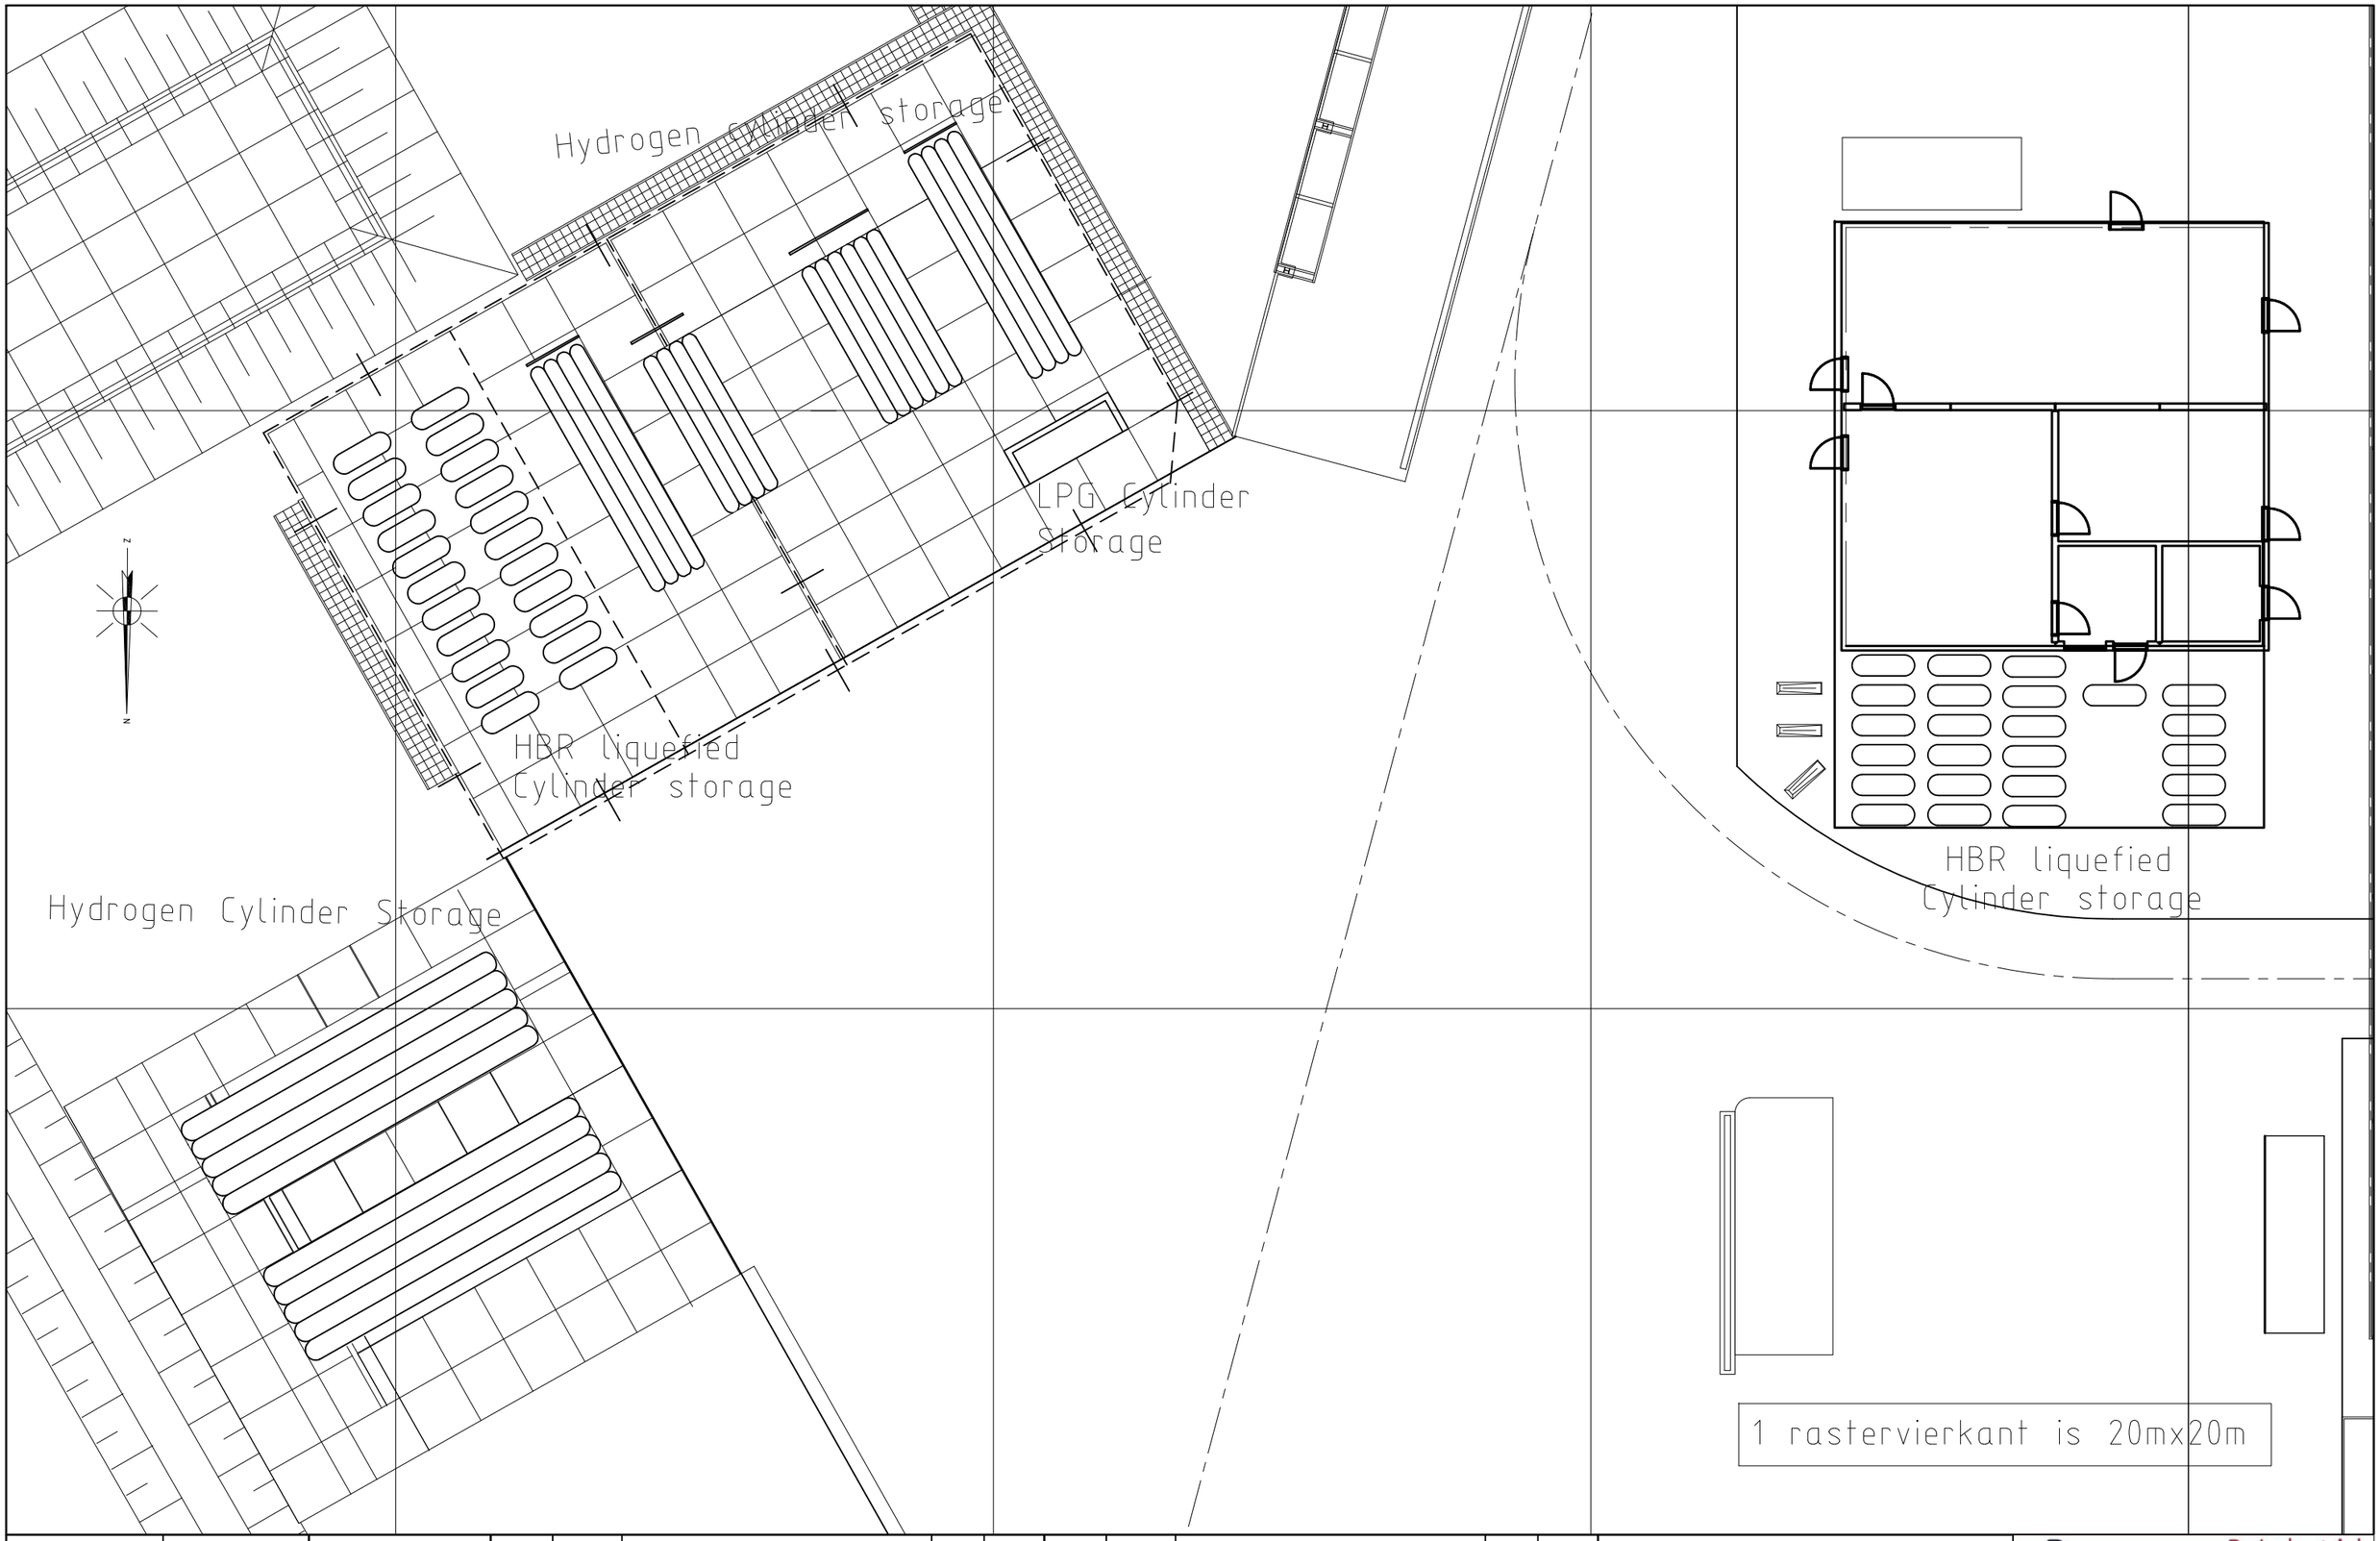

STATUS INSTALLATION	STATUS DRAWING												
		ENG. :											
		SCALE : 1:200											
Not existing ○	For engineering ○	DRAWN [redacted]	02	10-12-20	Update	I.S.							
Under construction ○	For construction ○	CHKD. :	01	11-11-20	New drawing	I.S.							
Operative ●	As built ●	DATE : 11-11-2020	REV.	DATE	DESCRIPTION	DRAWN	CHECKED	REV.	DATE	DESCRIPTION	DRAWN	CHECKED	

TITLE: Storage

Layout

Hydrogen Storage

DWG Nr.:03-06-06-0020-008 **REV. Nr.:** 02

AICL Industrial Products