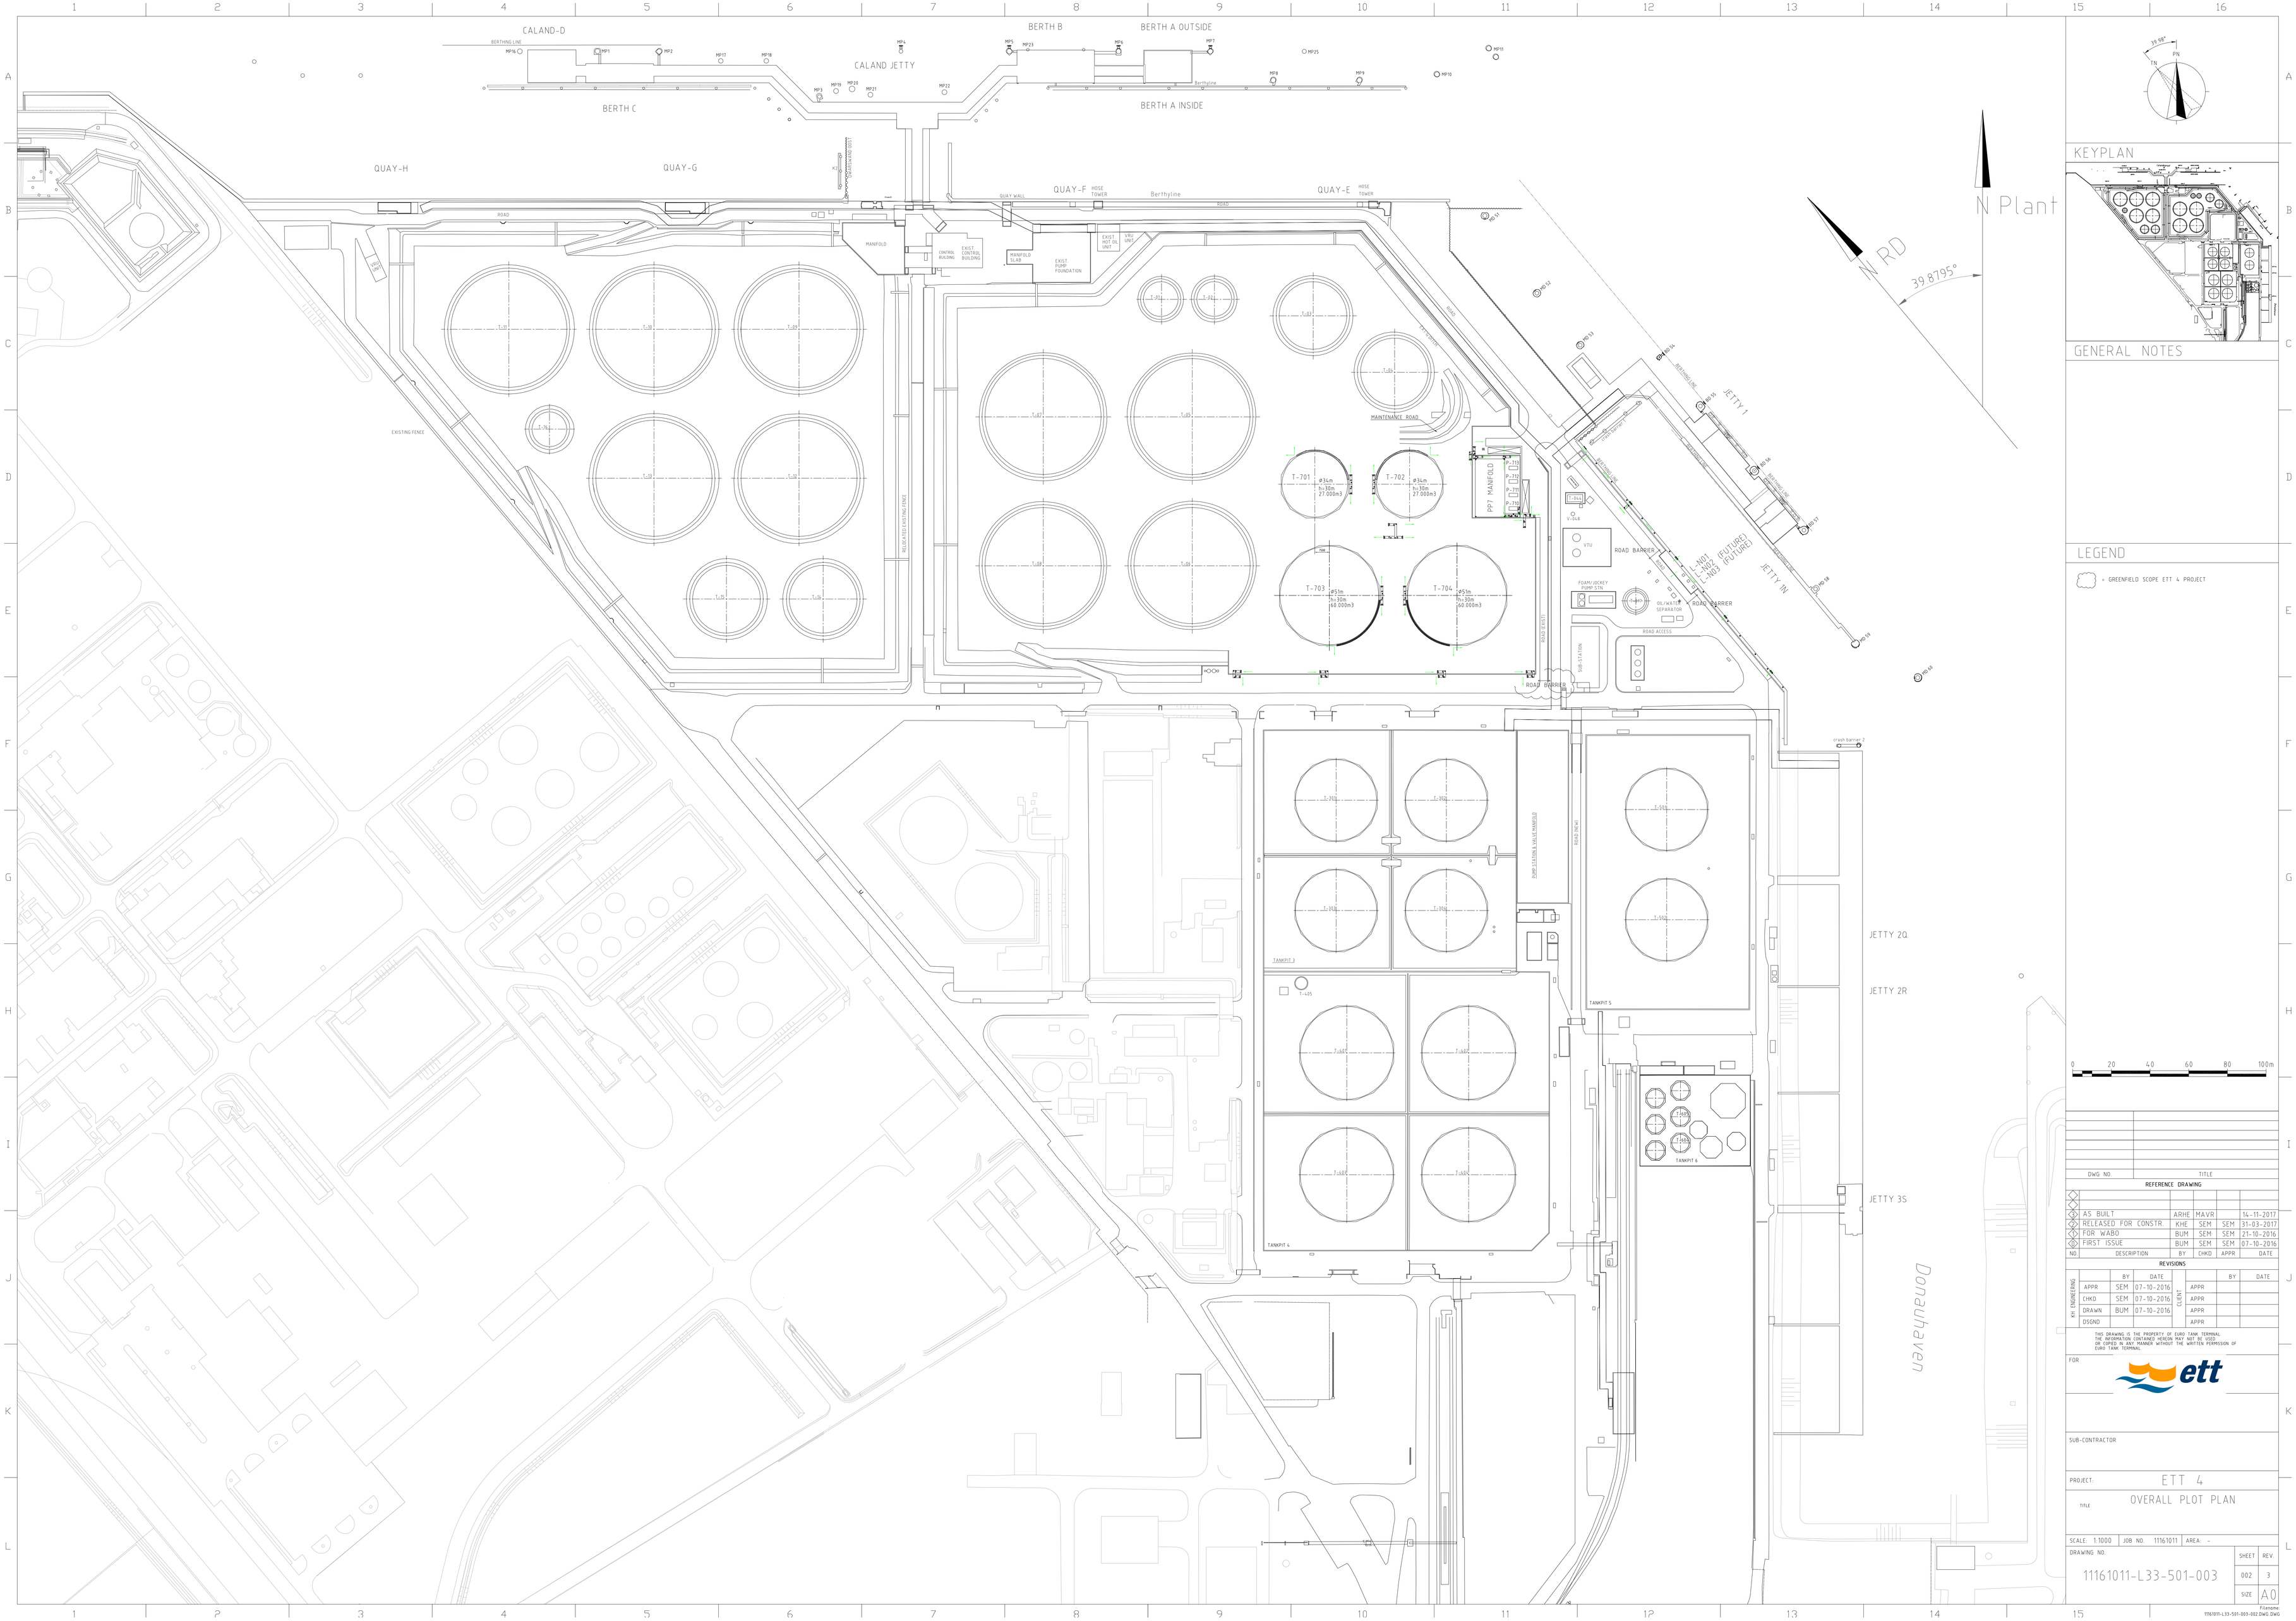

KEYPLAN

GENERAL NOTES

LEGEND

= GREENFIELD SCOPE ETT 4 PROJECT

0 20 40 60 80 100m

DWG. NO.	TITLE

REFERENCE DRAWING

NO.	DESCRIPTION	BY	CHKD	APPR	DATE
	AS BUILT	ARHE	MAVR		14-11-2017
	RELEASED FOR CONSTR.	KHE	SEM	SEM	31-03-2017
	FOR WABO	BUM	SEM	SEM	21-10-2016
	FIRST ISSUE	BUM	SEM	SEM	07-10-2016

REVISIONS

KF ENGINEERING	BY	DATE
APPR	SEM	07-10-2016
CHKD	SEM	07-10-2016
DRAWN	BUM	07-10-2016
DSGND		

CLIENT	BY	DATE
APPR		
APPR		
APPR		
APPR		

THIS DRAWING IS THE PROPERTY OF EURO TANK TERMINAL
THE INFORMATION CONTAINED HEREIN MAY NOT BE USED
OR COPIED IN ANY MANNER WITHOUT THE WRITTEN PERMISSION OF
EURO TANK TERMINAL

FOR

SUB-CONTRACTOR

PROJECT: ETT 4

TITLE: OVERALL PLOT PLAN

SCALE 1:1000 | JOB NO. 11161011 | AREA: -

DRAWING NO. 11161011-L33-501-003

SHEET 002 | REV. 3

SIZE A0

Filename: 11161011-L33-501-003-002.DWG.DWG