ORIGINAL DRAWING MADE ON DU PONT POLYESTER FILM

ANALYZE FOR SAFETY, ECOLOGY, AND MINIMUM ESSENTIAL DESIGN

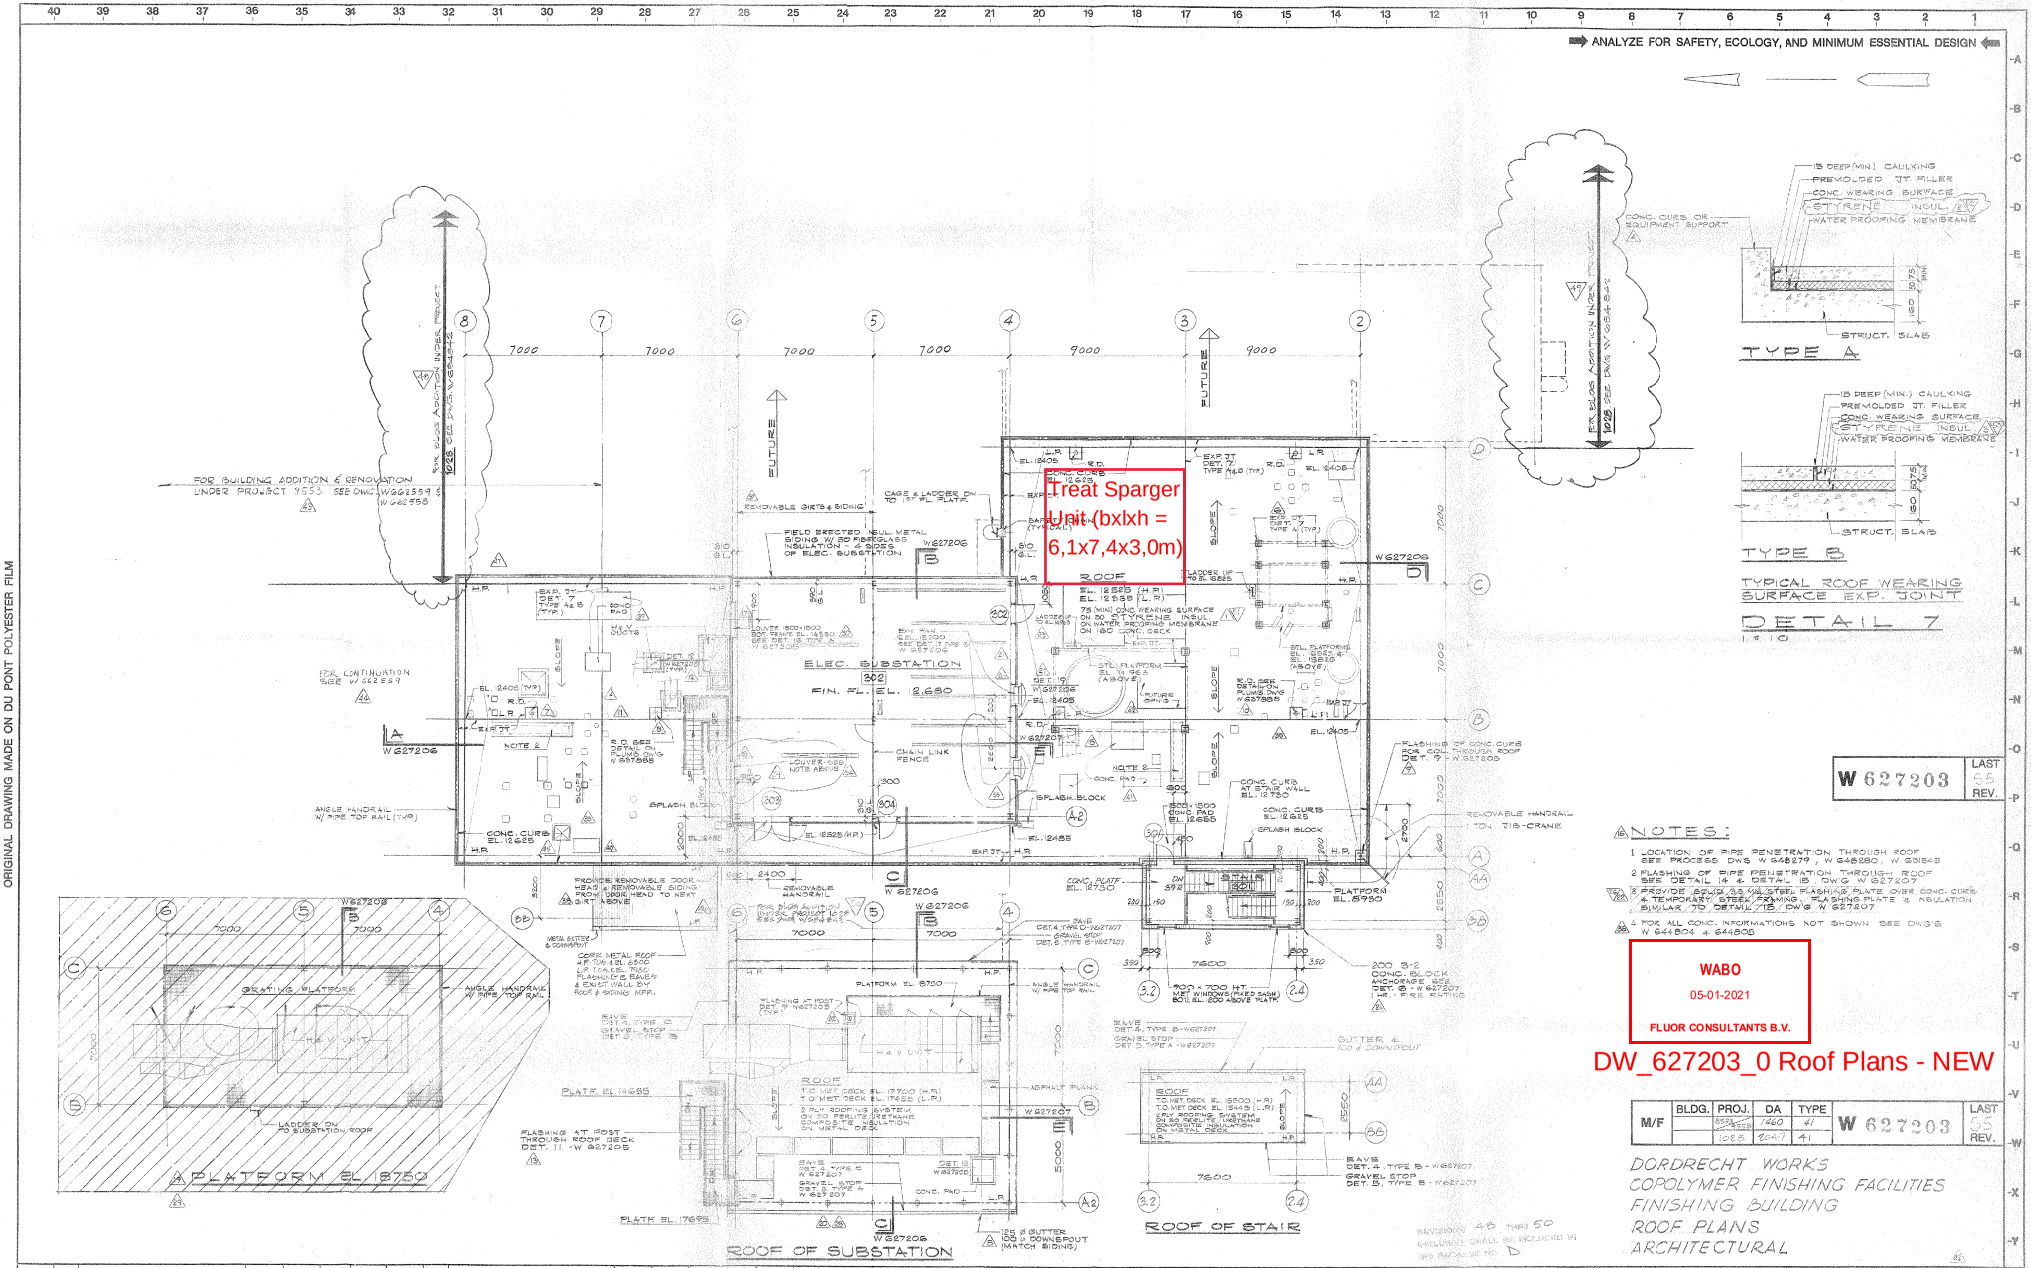

NOTES:

1. LOCATION OF PIPE PENETRATION THROUGH ROOF SEE PROCESS DWG W 648279, W 648280, W 635843
2. FLASHING OF PIPE PENETRATION THROUGH ROOF SEE DETAIL 14 & DETAIL 15 DWG W 627207
3. PROVIDE 2GUA 33 GAL STEEL FLASHING PLATE OVER CONC. CURB & TEMPORARY STEEL FRAMING. FLASHING PLATE & INSULATION SIMILAR TO DETAIL 7/15, DWG W 627207
4. FOR ALL CONC. INFORMATIONS NOT SHOWN SEE DWG'S W 644804 & 644805

WABO
05-01-2021
FLUOR CONSULTANTS B.V.

DW_627203_0 Roof Plans - NEW

M/F	BLDG.	PROJ.	DA	TYPE	W 627203	LAST REV.
		8553	1460	41		55
		1028	2047	41		

DORDRECHT WORKS
COPOLYMER FINISHING FACILITIES
FINISHING BUILDING
ROOF PLANS
ARCHITECTURAL

PROJ	NO.	REVISION	RVSD	CHKD	APPD	DATE
1028	54	REMOVED NOTE FOR FUTURE LOUVER & ADDED LOUVER				
	55	ADDED EXH. FAN				

PROJ	NO.	REVISION	RVSD	CHKD	APPD	DATE
8553	44	ADDED NOTE No 4				
	45	ADDED REMOV SIDING NOTES				
	46	REVISED & ADDED CONC. PADS				
9553	47	ADDED PROJ. 9553				
9553	48	ADDED INFO				
9553	49	ADDED DUCT CONC & EQUIP. FIRE				
9553	50	ADDED STAIR ROOF				
9553	51	REMOVED LADDER				
1028	52	ADDED REFERENCES TO PROJECT 1028				
9553	53	OTHERWISE WAS CELLULAR BLDG (AS BUILT)				

PROJ	NO.	REVISION	RVSD	CHKD	APPD	DATE
8553	8A	INDICATED FIRE RATING				
	8B	REVISED FUTURE OPNGS				
	8C	VOIDED NOTE No 8				
	8D	ADDED DETAIL MARK - DET. 19				
	8E	REV. ROOF PLAN & ADD. H&V EQUIP.				
	8F	VOIDED PLATFORM PLAN				
	8G	REV. LOUVER ELEV. (WAS 12980)				
	8H	RELOC. EXH. FAN & REV. ELEV. (WAS 15000)				
	8I	ADDED POSTS & FLASHING AT ROOF				
	8J	ADD & REV. CONC. PERS & FLOOR OPNG'S				

PROJ	NO.	REVISION	RVSD	CHKD	APPD	DATE
8553	1A	REVISED & ADDED NOTES				
	2A	RELOCATED ROOF DRAINS				
	3A	ADDED & RELOC. DET. NOTES W/ REF.				
	4A	ADD. ROOF OPNG. H&V DUCTS & CONC. N.38				
	5A	ADDED NOTES				
	6A	ADDED LOUVERS				
	7A	ADDED PLAN OF PLATFORM EL. 18750				
	8A	REVISED SUBSTATION ROOF PLAN				
	9A	ADDED EXH. FAN				
	10A	ADDED NOTE 3 & REF.				

STANDARDS

REFERENCE DRAWINGS

W 627201	ARCH.-PLANS	W 627858	PLUMBING
W 627202			
W 627203			
W 627205	ARCH.-ELEVS		
W 627209			
W 627207	ARCH.-SECS		
W 627208			
W 628794	MECH.-SECS		
W 635743	DIOXE SCHED.		
W 635738	ELEC.-PLANS		

THIS DRAWING HAS BEEN FURNISHED BY E. I. DU PONT DE NEMOURS & CO. THE INFORMATION AND KNOW-HOW THEREON MAY NOT BE USED NOR THE DRAWING REPRODUCED WITHOUT THE WRITTEN PERMISSION OF DU PONT. ALL REPRODUCTIONS IN WHOLE OR IN PART, INCLUDING VENDOR'S SHOP DRAWINGS, SHALL BEAR OR REFER TO THIS STAMP.

PROJECT 8553 - 9553 - 1028
SCALE 1:100
DRAWN
CHECKED
APPROVED-I.C.R.
APPROVED-FINAL

E. I. DU PONT DE NEMOURS & CO., INC.
WILMINGTON, DELAWARE
ENGINEERING DEPARTMENT
W 627203